

**City of Prince George  
HISTORY SHEET**

005107091

SHEET NUMBER

Roll Number 206-6775.000

Legal: LOT'S 4 BLOCK SW 14 D.L. 632 PLAN 10099

Address: ~~Aickinson Rd~~ 1730 OLD CARIBOO HWY

Sanitary Connection: # 10029 SIZE 4" MATERIAL PVC INV. 10.40 CONNECTED A476

Water Connection # B.I.D. SIZE 3/4" MATERIAL METER CONNECTED

Storm Connection: # SIZE MATERIAL INV. CONNECTED

Cash Receipt No's: WATER Pl. MARCH 21/63 SANITARY 0234 STORM

CURB FROM PROPERTY LINE

PAVEMENT WIDTH

B.C. HYDRO

UNDERGROUND CONNECTION

B.C. TELEPHONE

UNDERGROUND CONNECTION


INLAND GAS

**Information Sheets:**

**Comments:**

THE INFORMATION CONTAINED HEREIN IS FOR INTERNAL  
USE ONLY. NOT TO BE RELIED UPON UNLESS CONFIRMED  
BY SITE INSPECTION AND/OR INVESTIGATION.

SITE PLAN N.T.S.

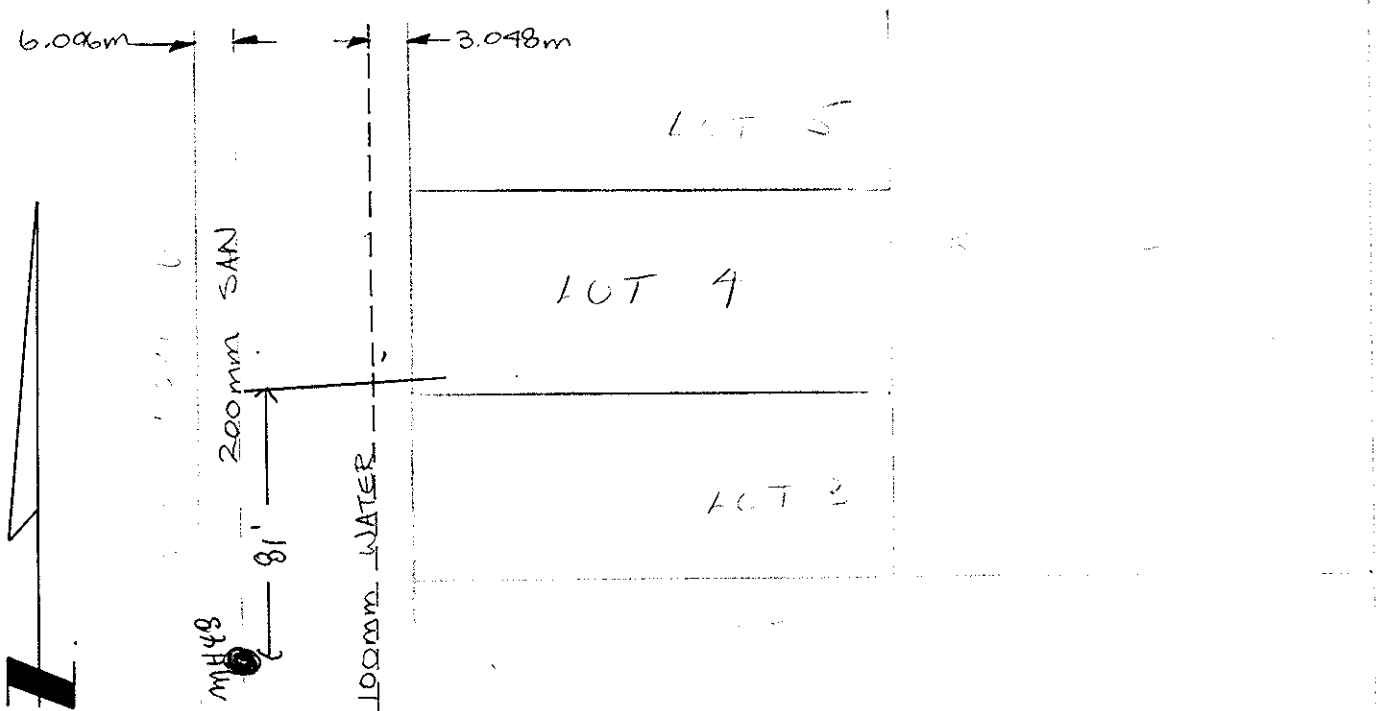

NO WATER LOCATION