


Lot Servicing

2863 FERRY AVE
Lot: A, Plan: 16331, DL: 1433

PID: 005110459

SERVICE	SIZE	MATERIAL	INSTALLED DATE	LOCATION	DETAILS
WATER	100MM	CU		NEW SERVICE NO LOCATION	CASH RECEIPT NUMBER 101015
SANITARY	200MM	PVC		NEW SERVICE NO LOCATION	CONNECTION # 49695
STORM	250MM	PVC		NEW SERVICE NO LOCATION	CONNECTION # 49696

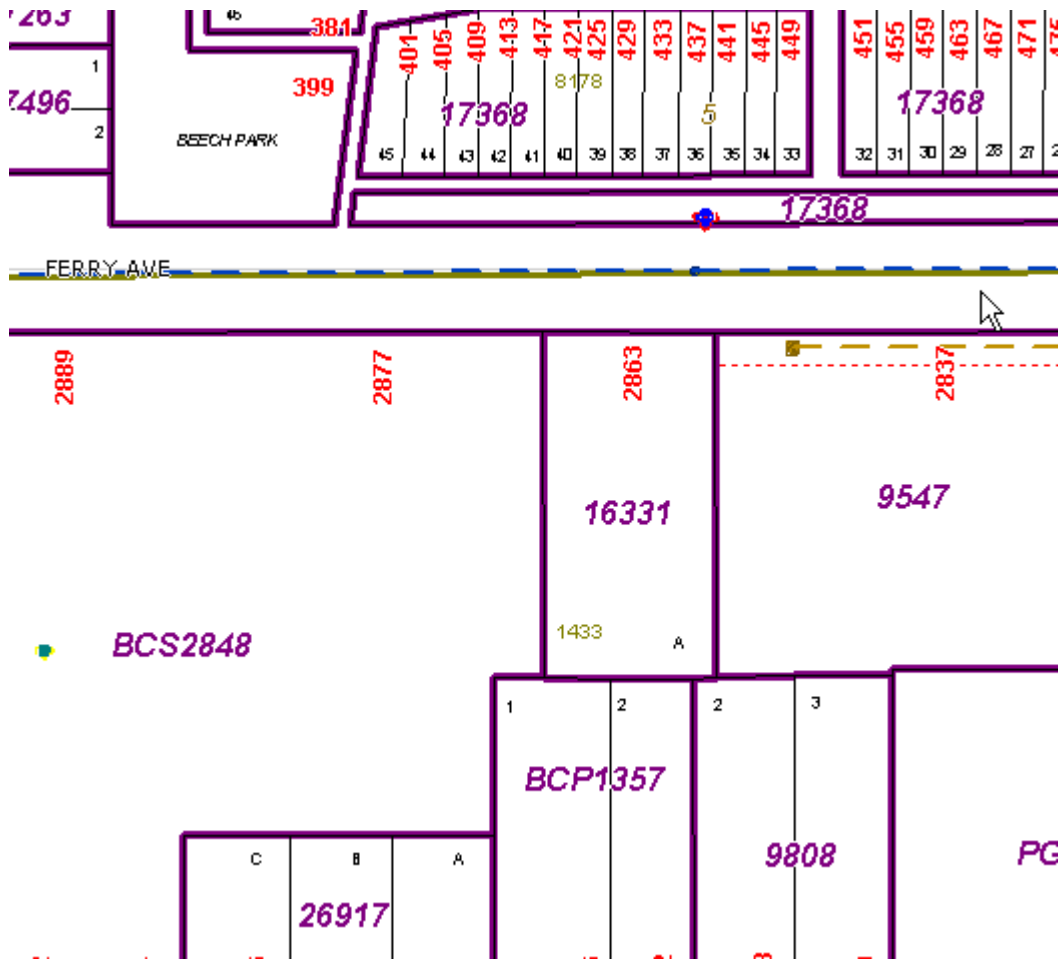

Accuracy not guaranteed unless confirmed by site inspection and/or investigation.
 Connection location between main and property line only.