

**City of Prince George
HISTORY SHEET**

FL

SHEET NUMBER

Roll Number 005144876

Legal: LOT'S 35 BLOCK / D.L. 2507 PLAN 20916

Address: 926 OCHAKWIN CRES

Sanitary Connection: # 8830 SIZE 100 mm MATERIAL A.C. INV. CONNECTED

Water Connection # 8830 SIZE 20 mm MATERIAL COPPER METER CONNECTED

Storm Connection: # SIZE MATERIAL INV. CONNECTED

Cash Receipt No's: WATER SANITARY STORM

CURB FROM PROPERTY LINE 4.877 m PAVEMENT WIDTH 10.363 m

B.C. HYDRO U/A UNDERGROUND CONNECTION



B.C. TELEPHONE U/A UNDERGROUND CONNECTION

INLAND GAS 3.048 m FROM R

Information Sheets:

Comments: WITH THAW WIRE.

**THE INFORMATION CONTAINED HEREIN IS FOR INTERNAL USE ONLY.
NOT TO BE RELIED UPON UNLESS CONFIRMED BY SITE INSPECTION AND/OR INVESTIGATION**

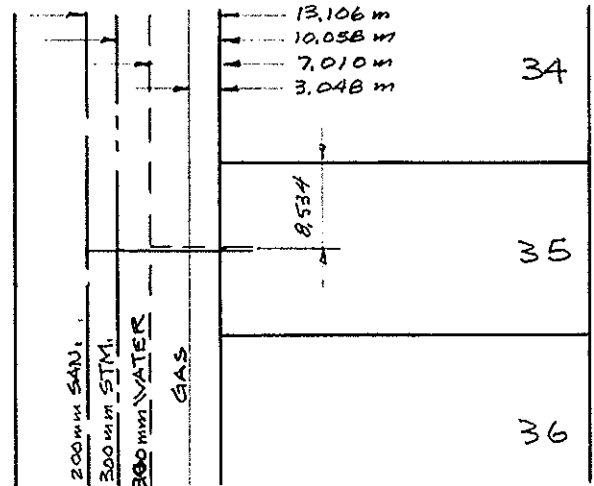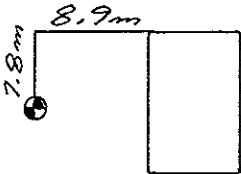

OCHAKWIN
CRES.

