

**City of Prince George
HISTORY SHEET**

005166900

SHEET NUMBER

Roll Number

926

Legal: LOT'S 2-3 BLOCK 108 D.L. 937 PLAN 752

Address: 129 N. NICHOLSON ST.

Sanitary Connection: # 3302 SIZE 100mm MATERIAL A.C. INV. 601,768 CONNECTED

Water Connection # 3333 SIZE 20mm MATERIAL C.U. METER CONNECTED

Storm Connection: # SIZE MATERIAL INV. CONNECTED

Cash Receipt No's: WATER SANITARY STORM

CURB FROM PROPERTY LINE 4.877m PAVEMENT WIDTH 10.363m


B.C. HYDRO 0/H UNDERGROUND CONNECTION

B.C. TELEPHONE 0/H UNDERGROUND CONNECTION


INLAND GAS 1.524m FROM WEST SIDE OF LANE

Information Sheets:

Comments: WITH THAW WIRE.

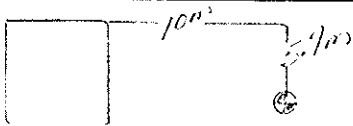

SITE PLAN N.T.S.

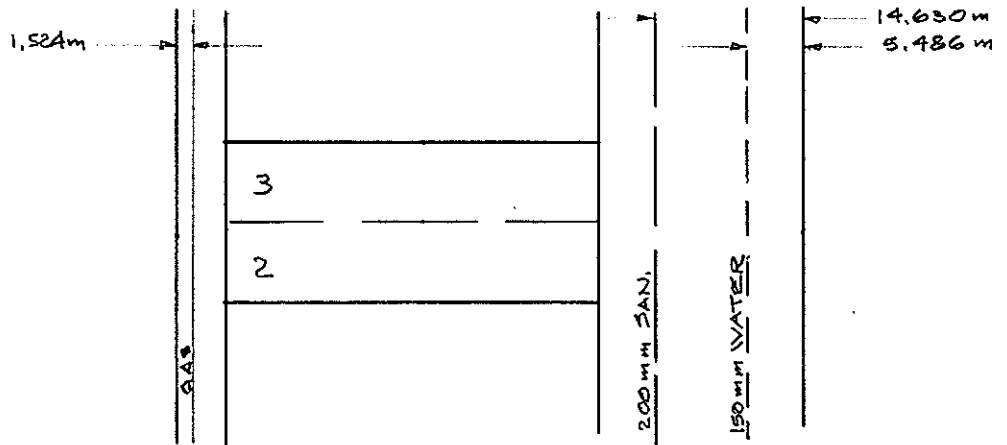

N. NICHOLSON ST.