

# City of Prince George HISTORY SHEET

SHEET NUMBER

PID # 005177171

Legal: LOTS 108

BLOCK

D.L. 2507

PLAN 16227

Address: 1362 ALEZA CRES.

Sanitary Connection: # 5266 SIZE 100 mm MATERIAL A.C. INV. 603.192 CONNECTED

Water Connection: # 5266 SIZE 20 mm MATERIAL G.U. METER CONNECTED

Storm Connection: # SIZE mm MATERIAL INV. CONNECTED

Cash Receipt No's: WATER SANITARY STORM

CURB FROM PROPERTY LINE 4.877 m

PAVEMENT WIDTH 10.363

B.C. HYDRO U/G UNDERGROUND CONNECTION



B.C. TELEPHONE U/G UNDERGROUND CONNECTION

INLAND GAS 3.657 m FROM SOUTH SIDE OF ALEZA CRES.

Information Sheets:

Comments: WITH THAW WIRE.

**THE INFORMATION CONTAINED HEREIN IS FOR INTERNAL USE ONLY.  
NOT TO BE RELIED UPON UNLESS CONFIRMED BY SITE INSPECTION AND/OR INVESTIGATION**

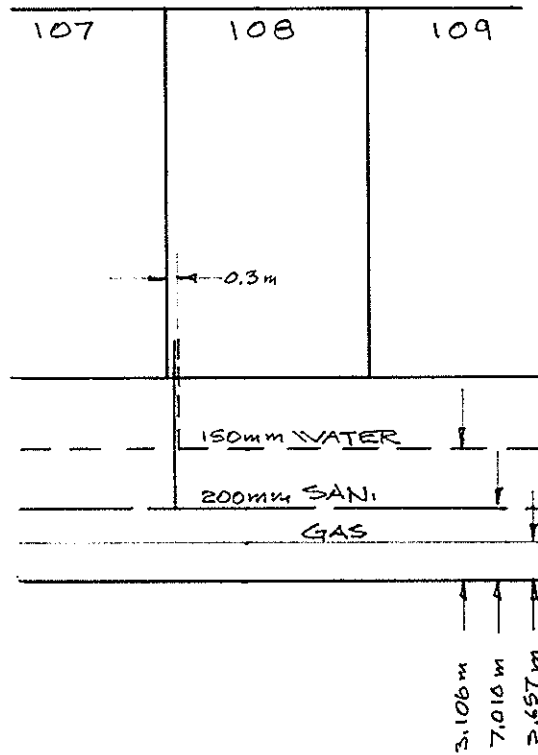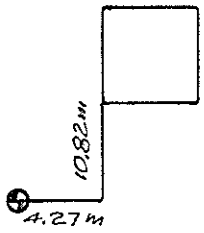

ALEZA CRES.

