

**City of Prince George
HISTORY SHEET**

967

1974 SFG Assessment

SHEET NUMBER **8238** Roll Number 20F 325.000

Legal: LOT'S 5-6 BLOCK 25 D.L. 933 PLAN 727

Address: 1241 - 1243 Clark Avenue

Sanitary Connection: # SIZE 4" MATERIAL AC INV. CONNECTED 1971

Water Connection # SIZE 3/4" MATERIAL CU METER CONNECTED yes

Storm Connection: # SIZE MATERIAL INV. CONNECTED

Cash Receipt No's: WATER pd SANITARY pd STORM

CURB FROM PROPERTY LINE PAVEMENT WIDTH

B.C. HYDRO 0H UNDERGROUND CONNECTION

B.C. TELEPHONE 0H UNDERGROUND CONNECTION


INLAND GAS

Information Sheets:

Comments:

SITE PLAN N.T.S.

Sewer

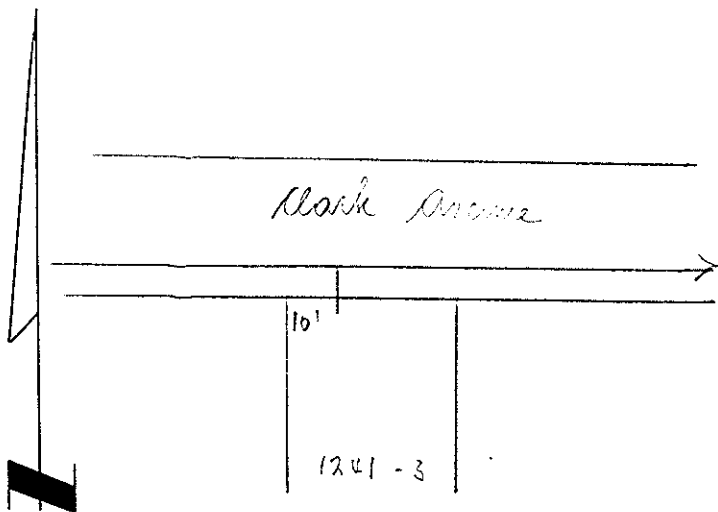

Water

