


Lot Servicing

4855 POTY RD 5005 HWY 16 E
Plan: B1643, **DL:** 954 REM SE4

PID: 005195438

SERVICE	SIZE	MATERIAL	INSTALLED DATE	LOCATION	DETAILS
WATER	13MM	CU		12.5M W OF E PL DISCONNECTED 2007	THAW WIRE N
WATER	13MM	CU		11.5M W OF E PL	THAW WIRE N
WATER	50MM	CU	25-Oct-2007	SP 5.3M E OF SAN MANHOLE # 418203 8.0M S	CASH RECEIPT NUMBER 100793
SANITARY	100MM	PVC		12.0M W OF NE COR PL	CLEANOUT FR SAN M/H 5M E 8.3M S

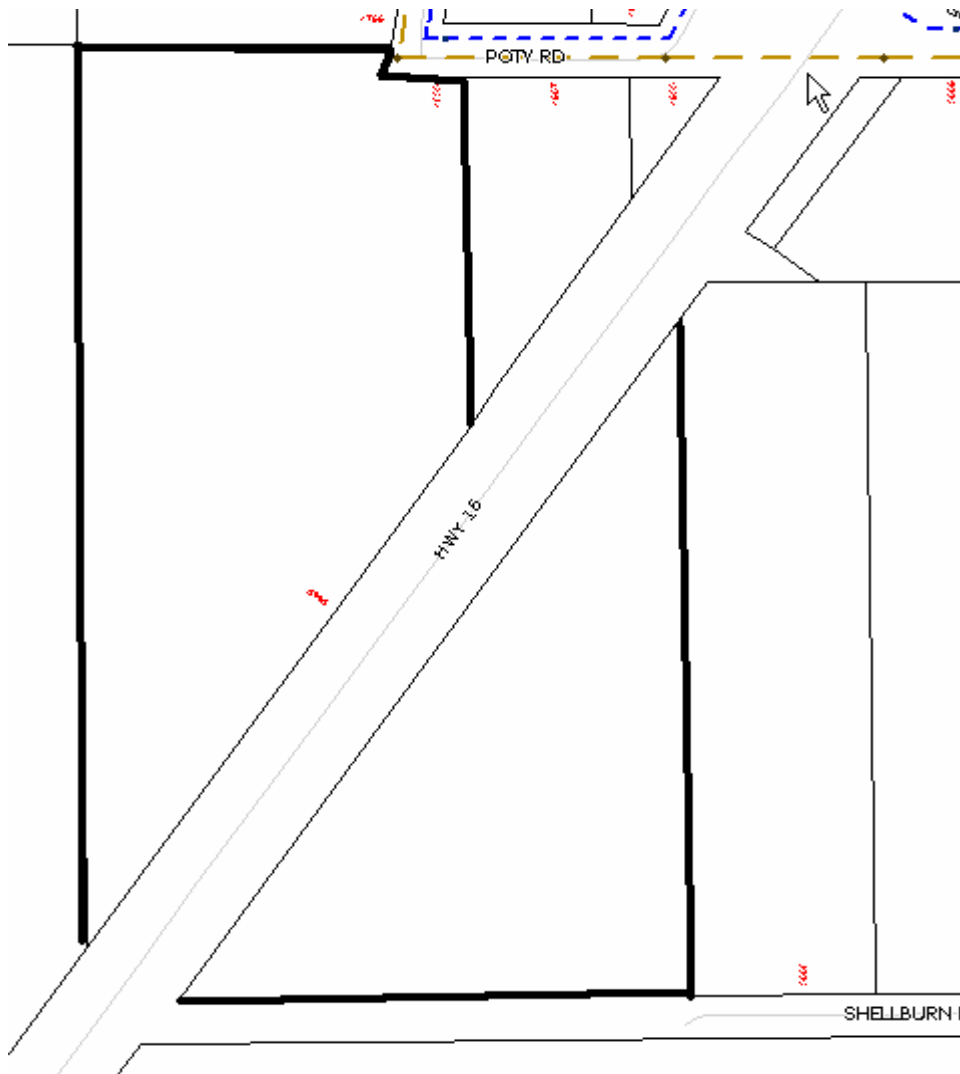

Accuracy not guaranteed unless confirmed by site inspection and/or investigation.
 Connection location between main and property line only.