

City of Prince George HISTORY SHEET

SHEET NUMBER

Roll Number 005195896

Legal: LOT'S 63 BLOCK _____ D.L. 1427 PLAN 15089

Address: 374 RILEY DR.

Sanitary Connection: # 5086 SIZE _____ MATERIAL _____ INV. _____ CONNECTED _____

Water Connection # 5086 SIZE 20mm MATERIAL Cu METER _____ CONNECTED _____

Storm Connection: # _____ SIZE _____ MATERIAL _____ INV. _____ CONNECTED _____

Cash Receipt No's: WATER _____ SANITARY _____ STORM _____

CURB FROM PROPERTY LINE _____ PAVEMENT WIDTH _____


B.C. HYDRO _____ UNDERGROUND CONNECTION _____

B.C. TELEPHONE _____ UNDERGROUND CONNECTION _____

INLAND GAS _____

Information Sheets: _____

Comments: _____

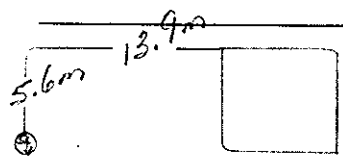

SITE PLAN N.T.S.

