

**City of Prince George
HISTORY SHEET**

JJ

SHEET NUMBER

Roll Number 005212804

Legal: LOT'S 6 BLOCK 8 D.L. 1426 PLAN 721

Address: 2758 OAK ST.

Sanitary Connection: # 7773 SIZE 100mm MATERIAL A.C INV. 579.621 CONNECTED

Water Connection # 7788 SIZE 20mm MATERIAL CU METER CONNECTED

Storm Connection: # SIZE MATERIAL INV. CONNECTED

Cash Receipt No's: WATER SANITARY 356 STORM

CURB FROM PROPERTY LINE 4.877m PAVEMENT WIDTH 10.363m

B.C. HYDRO 0/H UNDERGROUND CONNECTION



B.C. TELEPHONE 0/H UNDERGROUND CONNECTION

INLAND GAS 3.657m FROM R

Information Sheets:

Comments: WITH THAW WIRE,

**THE INFORMATION CONTAINED HEREIN IS FOR INTERNAL USE ONLY.
NOT TO BE RELIED UPON UNLESS CONFIRMED BY SITE INSPECTION AND/OR INVESTIGATION**

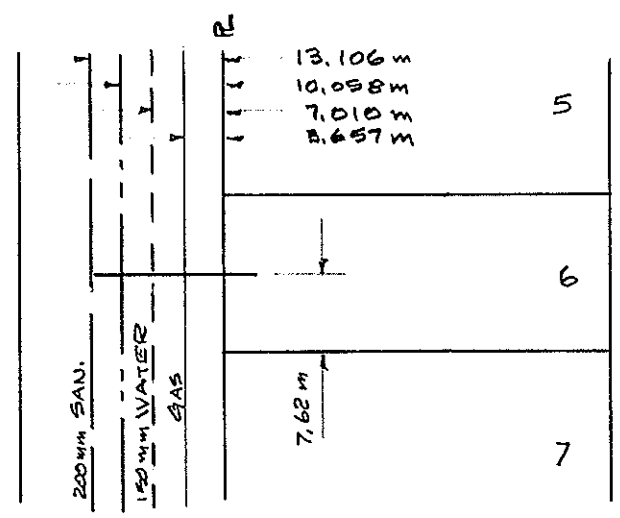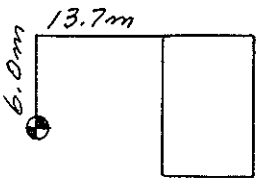

OAK ST.