

City of Prince George HISTORY SHEET

SHEET NUMBER **5669** Roll Number *00521301*

Legal: LOT'S *B* BLOCK D.L. *2433* PLAN *24173*

Address: *7515 CARR*

Sanitary Connection: # *13809* SIZE *100mm* MATERIAL *PVC* INV. *35.705* CONNECTED

Water Connection # *12039* SIZE *3/4"* MATERIAL *Cu* METER CONNECTED

Storm Connection: # SIZE MATERIAL INV. CONNECTED

Cash Receipt No's: WATER *1294* SANITARY STORM

CURB FROM PROPERTY LINE PAVEMENT WIDTH

B.C. HYDRO UNDERGROUND CONNECTION


B.C. TELEPHONE UNDERGROUND CONNECTION

INLAND GAS

Information Sheets:

Comments:

WATER STANDPIPE IS 7' FROM STANDPIPE FOR LOT A

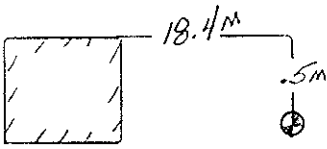

SITE PLAN N.T.S.

