

**City of Prince George
HISTORY SHEET**

00526804
320
346

SHEET NUMBER

Roll Number

Legal: LOT'S 6-7-2 BLOCK 70 D.L. 937 PLAN 752

Address: 337 KELLY ST.

Sanitary Connection: # 3104 SIZE 100mm MATERIAL A.C. INV. 598.068 CONNECTED

Water Connection # 3185 SIZE 20mm MATERIAL C.U. METER CONNECTED

Storm Connection: # SIZE MATERIAL INV. CONNECTED

Cash Receipt No's: WATER SANITARY STORM

CURB FROM PROPERTY LINE 4.877m PAVEMENT WIDTH 10.363m


B.C. HYDRO 0/H UNDERGROUND CONNECTION

B.C. TELEPHONE 0/H UNDERGROUND CONNECTION


INLAND GAS 1.524m FROM WEST SIDE OF LANE.

Information Sheets:

Comments:

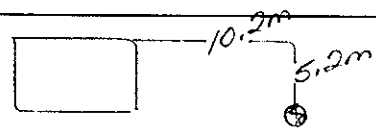

SITE PLAN N.T.S.

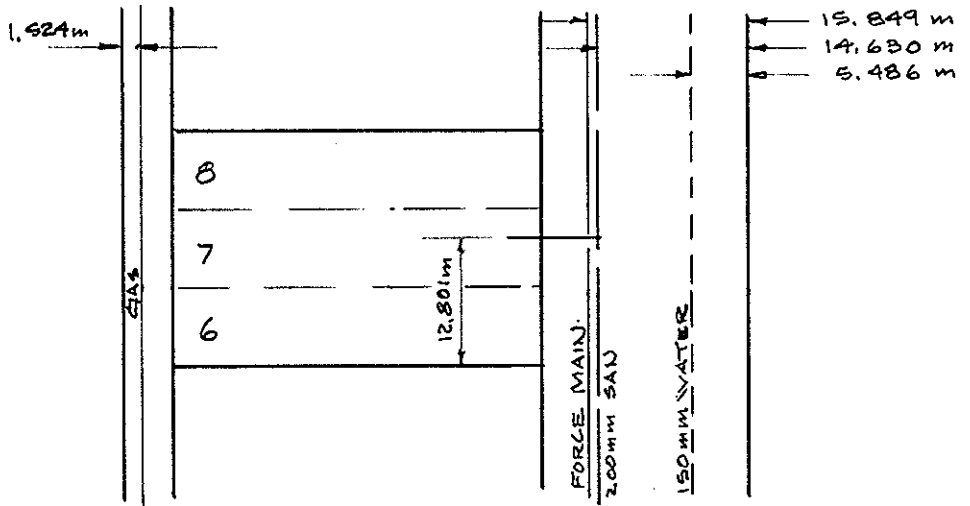

KELLY ST.