



City of Prince George  
**History Sheet**

PID:	005290619
SD/MU:	
WO:	

Civic Address: 3110 15th Ave

Legal Description: Lot: 3 District Lot: 936 Plan: 30757


Service Type	Diameter (mm)	Material	Invert Elev at main (m)	Invert Elev at property line (m)	Invert Depth at service end (m)	Distance into property (m)	Installation Date
Sanitary	100mm	AC	-	597.05	1.52	-	January 1957
Water	100mm	Copper	-	-	-	-	August 1964
Storm	200mm	Vit	-	597.10	1.55	-	January 1962

Service Connection Location				Sanitary (m)	Storm (m)
Distance from downstream San MH	856	towards upstream San MH	728	53.32	
200mm Storm service connected to Stm MH 3199					

Power	Size	Communications	Size	Cable	Size	Gas	Size
BC Hydro	-	Telus	-	Shaw	-	FortisBC	-
Underground Service		Underground Service		Underground Service			

Installed by:	Survey Date:	-
Comments:		

**NOT TO SCALE** The information contained herein is for internal use only.  
Not to be relied on unless confirmed by site inspection and/or investigation.

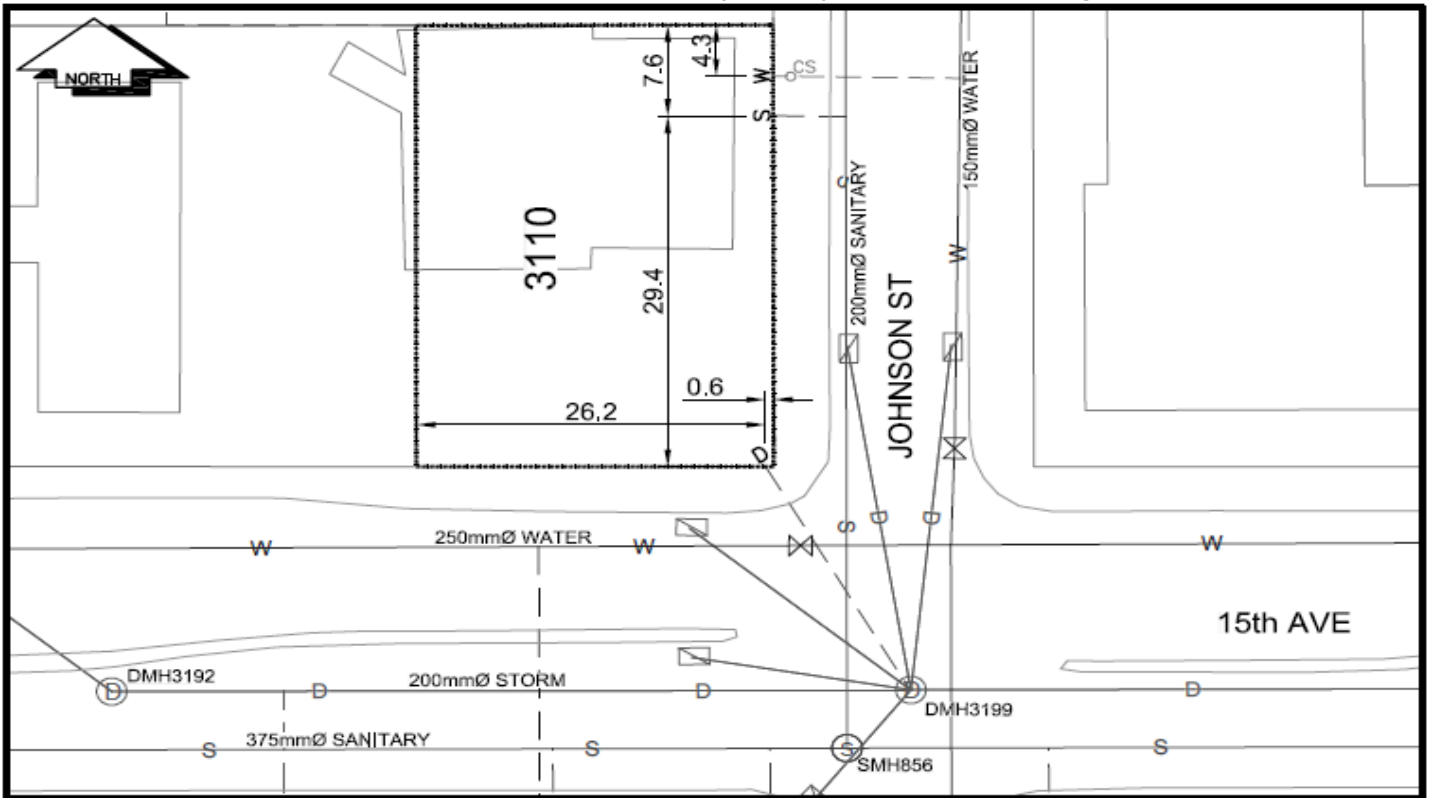

LEGEND:							
CS	CURB STOP	--- W	WATER SERVICE	--- S	SANITARY SERVICE	--- D	STORM SERVICE
CO	CLEAN OUT	---	GAS	--- G	GAS	---	ENCUMBERANCE
W	WATER VALVE	--- F	FIRE HYDRANT	---		---	

**NOT TO SCALE**