



City of Prince George  
**History Sheet**

PID:	005298181
SD/MU:	
WO:	

Civic Address: 2340, 2342, 2344, 2348 Westwood Drive

Legal Description: Lot: 1 District Lot: 8170 Plan: 30487


Service Type	Diameter (mm)	Material	Invert Elev at main (m)	Invert Elev at property line (m)	Invert Elev at service end (m)	Distance into property (m)	Installation Date
Sanitary	150mm	Unknown	-	-	-	-	October 1994
Water	40mm	Copper	585.76	585.77	-	-	May 1985
Storm	N/A	N/A	-	-	-	-	

Service Connection Location	Sanitary (m)	Storm (m)
150mm Sanitary service connected to San MH 2954	-	
Distance from downstream Stm MH - towards upstream Stm MH	-	

Power	Size	Communications	Size	Cable	Size	Gas	Size
BC Hydro	-	Telus	-	Shaw	-	FortisBC	-
Overhead Service		Overhead Service		Overhead Service			

Installed by:	Survey Date:	-
Comments: Water as per January 2015 locate.		

**NOT TO SCALE** The information contained herein is for internal use only.  
Not to be relied on unless confirmed by site inspection and/or investigation.

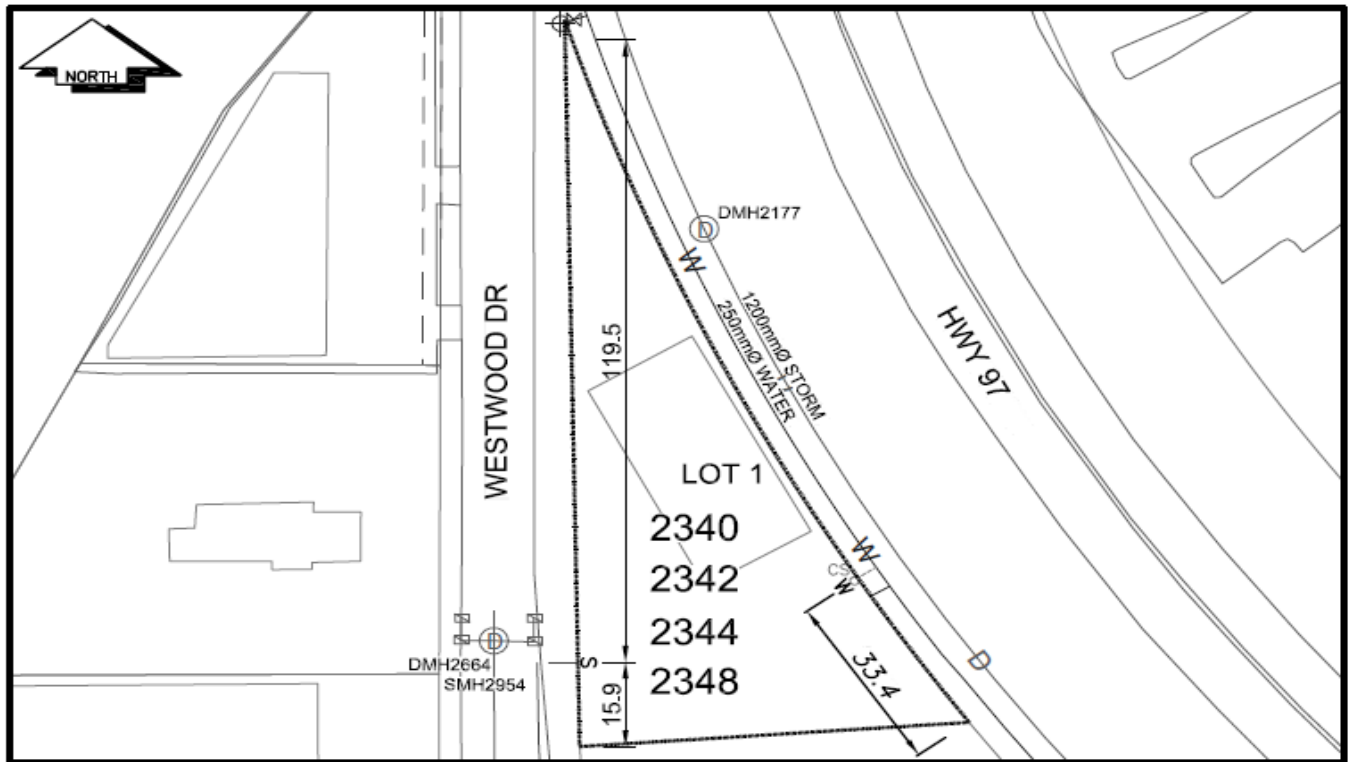

CS <sup>o</sup> CURB STOP	— W — WATER SERVICE	— S — STORM SERVICE
CO <sup>o</sup> CLEAN OUT	- - - S - - - SANITARY SERVICE	— G — GAS
⊗ WATER VALVE	— F — FIRE HYDRANT	- - - - - ENCUMBRANCE

**NOT TO SCALE**