

City of Prince George HISTORY SHEET

SHEET NUMBER **7290** Roll Number **308-0509**

Legal: LOT'S **6** BLOCK **4047** PLAN **21914**

Address: **6017 KINGHEN STREET**
~~RIM~~

Sanitary Connection: # **12710** SIZE **4"** MATERIAL INV. CONNECTED

Water Connection # SIZE **20mm** MATERIAL **CU** METER CONNECTED

Storm Connection: # SIZE MATERIAL INV. CONNECTED

Cash Receipt No's: WATER SANITARY STORM

CURB FROM PROPERTY LINE PAVEMENT WIDTH


B.C. HYDRO UNDERGROUND CONNECTION

B.C. TELEPHONE UNDERGROUND CONNECTION

INLAND GAS

Information Sheets:

Comments:

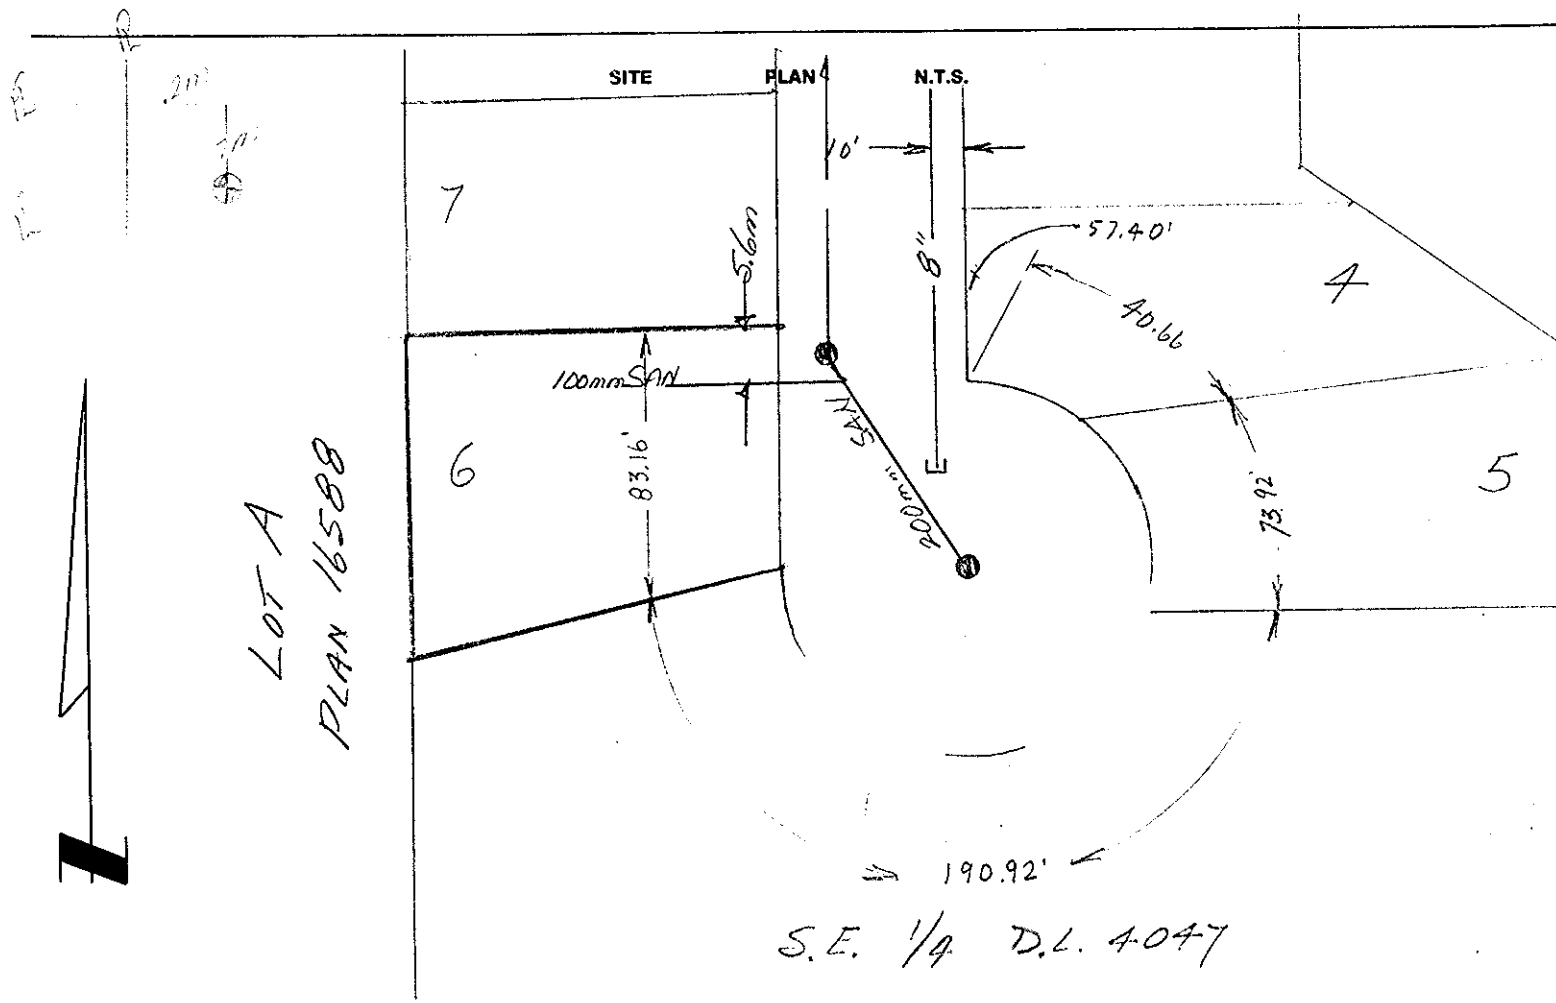

S.E. 1/4 D.L. 4047