

City of Prince George
HISTORY SHEET

DS
005320071

SHEET NUMBER **7485** Roll Number

Legal: LOT'S **5** BLOCK D.L. **808** PLAN **20832**

Address: **2164** **PROGRESS RD.**

Sanitary Connection: # SIZE MATERIAL INV. CONNECTED

Water Connection # SIZE MATERIAL METER CONNECTED

Storm Connection: # SIZE MATERIAL INV. CONNECTED

Cash Receipt No's: WATER SANITARY STORM

CURB FROM PROPERTY LINE PAVEMENT WIDTH

B.C. HYDRO UNDERGROUND CONNECTION


B.C. TELEPHONE UNDERGROUND CONNECTION

INLAND GAS

Information Sheets:

Comments:

SITE PLAN N.T.S.

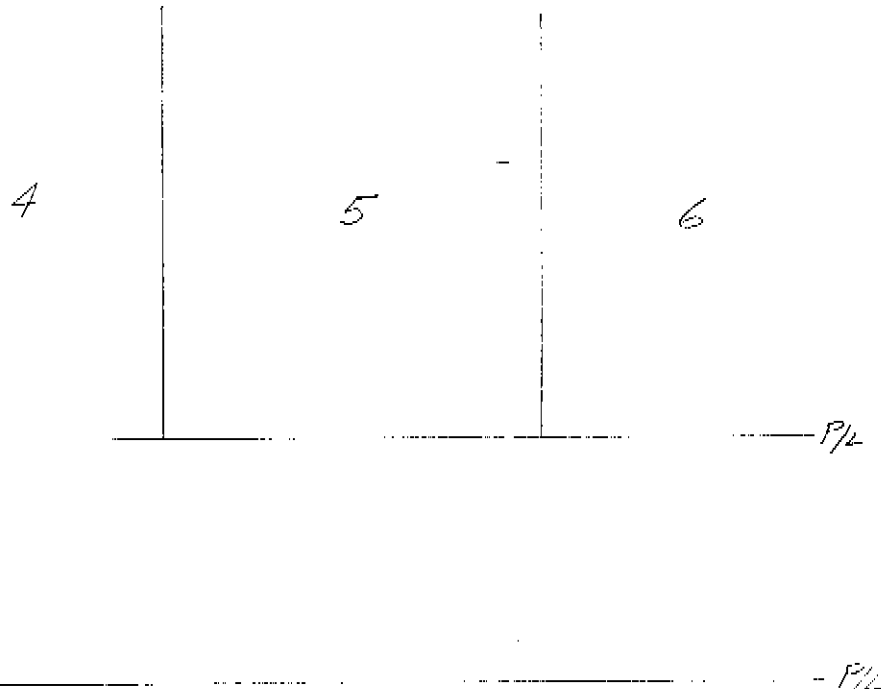

PROGRESS RD.