

City of Prince George HISTORY SHEET

SHEET NUMBER

Roll Number 005330092

Legal: LOT'S 1/0 BLOCK _____ D.L. 1/27 PLAN 16763

Address: 139 McQUEEN DR.

Sanitary Connection: # 6109 SIZE 100mm MATERIAL AC INV. 604.817 CONNECTED

Water Connection # 6109 SIZE 50mm MATERIAL Cu METER _____ CONNECTED

Storm Connection: # _____ SIZE _____ MATERIAL _____ INV. _____ CONNECTED

Cash Receipt No's: WATER _____ SANITARY _____ STORM _____

CURB FROM PROPERTY LINE 4.877m PAVEMENT WIDTH 10.36m


B.C. HYDRO _____ UNDERGROUND CONNECTION _____

B.C. TELEPHONE _____ UNDERGROUND CONNECTION _____

INLAND GAS _____

Information Sheets: _____

Comments: _____

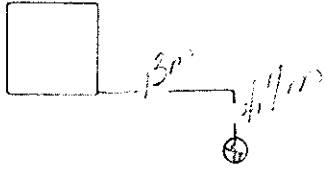

SITE PLAN N.T.S.

