

**City of Prince George
HISTORY SHEET**

005 332782
FM

SHEET NUMBER _____ Roll Number _____

Legal: LOT'S 225 BLOCK — D.L. 482 PLAN 20916

Address: 4417 URQUHART CRES.

Sanitary Connection: # 8711 SIZE 100 mm MATERIAL _____ INV. _____ CONNECTED _____

Water Connection # 8711 SIZE 20 mm MATERIAL COPPER METER _____ CONNECTED _____

Storm Connection: # _____ SIZE _____ MATERIAL _____ INV. _____ CONNECTED _____

Cash Receipt No's: WATER _____ SANITARY _____ STORM _____

CURB FROM PROPERTY LINE 4.877 m PAVEMENT WIDTH 10.363 m

B.C. HYDRO U/G UNDERGROUND CONNECTION _____



B.C. TELEPHONE U/G UNDERGROUND CONNECTION _____

INLAND GAS AS SHOWN

Information Sheets: _____

Comments: WITH THAW WIRE.

**THE INFORMATION CONTAINED HEREIN IS FOR INTERNAL USE ONLY.
NOT TO BE RELIED UPON UNLESS CONFIRMED BY SITE INSPECTION AND/OR INVESTIGATION**

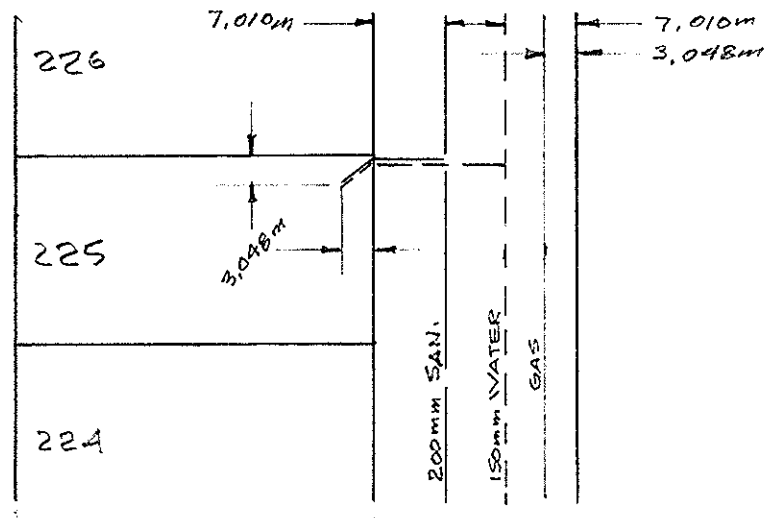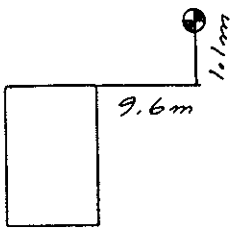

URQUHART
CRES.