

City of Prince George

HISTORY SHEET

SHEET NUMBER

PID # 005-339-715

Legal: LOTS 7 BLOCK D.L. 8178 PLAN 18 143

Address: 2909 PINEWOOD AVE.

Sanitary Connection: # 6359 SIZE 100 mm MATERIAL A.C. INV. 591,740 CONNECTED

Water Connection: # 6359 SIZE 20 mm MATERIAL C.U. METER CONNECTED

Storm Connection: # SIZE mm MATERIAL INV. CONNECTED

Cash Receipt No's: WATER SANITARY STORM

CURB FROM PROPERTY LINE 3.657 m PAVEMENT WIDTH 12.801 m

B.C. HYDRO U/G UNDERGROUND CONNECTION



B.C. TELEPHONE U/G UNDERGROUND CONNECTION

INLAND GAS 3.048 m FROM FL.

Information Sheets:

Comments: WITH THAW WIRE.

**THE INFORMATION CONTAINED HEREIN IS FOR INTERNAL USE ONLY.
NOT TO BE RELIED UPON UNLESS CONFIRMED BY SITE INSPECTION AND/OR INVESTIGATION**

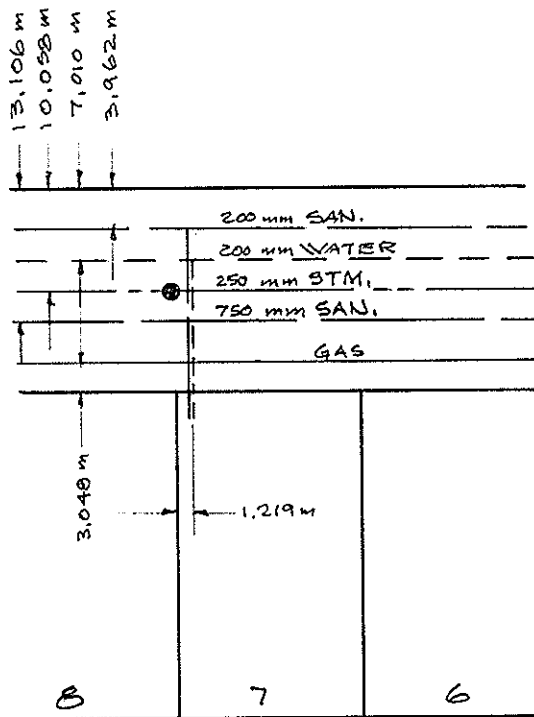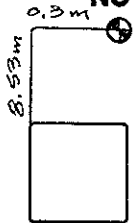

PINEWOOD AVE.

