

**City of Prince George
HISTORY SHEET**

005346649 FM

SHEET NUMBER _____ Roll Number _____

Legal: LOT'S 207 BLOCK _____ D.L. 482 PLAN 20916

Address: 4406 URQUHART CRES.

Sanitary Connection: # 8693 SIZE 100mm MATERIAL A.C. INV. _____ CONNECTED

Water Connection # 8693 SIZE 20mm MATERIAL COPPER METER _____ CONNECTED

Storm Connection: # _____ SIZE _____ MATERIAL _____ INV. _____ CONNECTED

Cash Receipt No's: WATER _____ SANITARY _____ STORM _____

CURB FROM PROPERTY LINE 4.877 m PAVEMENT WIDTH 10.363 m

B.C. HYDRO U/G UNDERGROUND CONNECTION




B.C. TELEPHONE U/G UNDERGROUND CONNECTION

INLAND GAS AS SHOWN

Information Sheets:

Comments: WITH THAW WIRE

**THE INFORMATION CONTAINED HEREIN IS FOR INTERNAL USE ONLY.
NOT TO BE RELIED UPON UNLESS CONFIRMED BY SITE INSPECTION AND/OR INVESTIGATION**

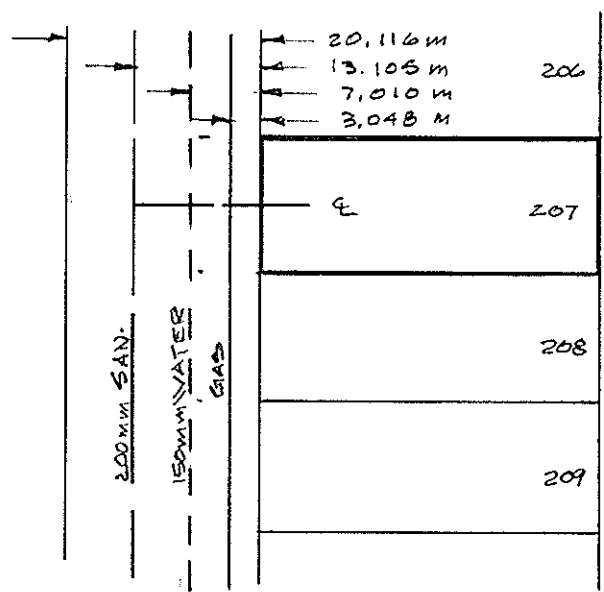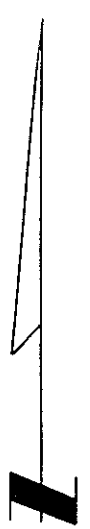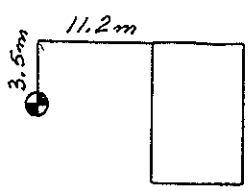

URQUHART CRES.