

City of Prince George HISTORY SHEET

SHEET NUMBER _____ Roll Number 005353661

Legal: LOT'S 1 BLOCK _____ D.L. 753 PLAN 30349

Address: 5150 DOMANO BLVD.

Sanitary Connection: # _____ SIZE 100 mm MATERIAL PVC INV. _____ CONNECTED _____

Water Connection # _____ SIZE 25 mm MATERIAL Cu METER _____ CONNECTED _____

Storm Connection: # _____ SIZE 150 mm MATERIAL PVC INV. _____ CONNECTED _____

Cash Receipt No's: WATER _____ SANITARY _____ STORM _____


CURB FROM PROPERTY LINE _____ PAVEMENT WIDTH _____

B.C. HYDRO O/H UNDERGROUND CONNECTION YES

B.C. TELEPHONE U/G UNDERGROUND CONNECTION YES

INLAND GAS U/G

Information Sheets: Prepared by Duncan & The information contained herein is for internal use only. Not to be relied upon unless confirmed by site inspection and/or investigation.

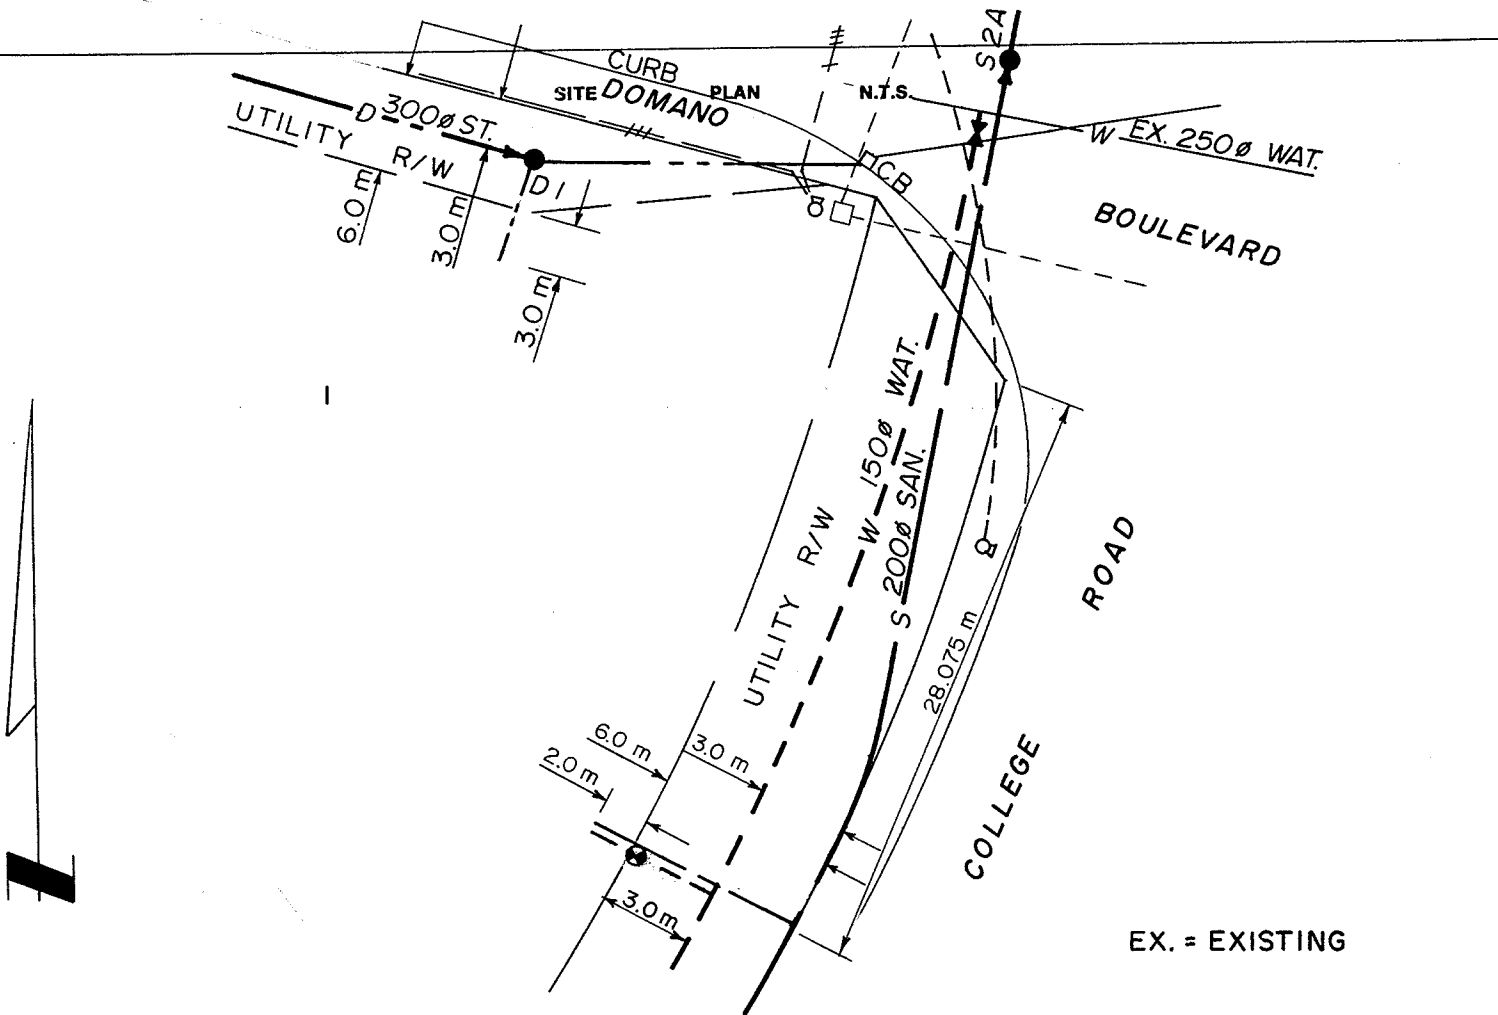

EX. = EXISTING