



City of Prince George
History Sheet

PID:	005356644
MU:	102112
WO:	99399

Civic Address: 2963, 2965 Hopkins Rd

Legal Description: Lot: 5 District Lot: 1433 Plan: 30304


Service Type	Diameter (mm)	Material	Invert Elev at main (m)	Invert Elev at property line (m)	Invert Elev at service end (m)	Distance into property (m)	Installation Date
Sanitary	100mm	PVC	-	-	-	-	December 1979
Water (W1)	20mm	Copper	-	-	-	-	December 1979
Water (W2)	25mm	Copper	592.29	593.65	593.71	1.00	June 2019
Storm	N/A	N/A	-	-	-	-	

Service Connection Location				Sanitary (m)	Storm (m)
Distance from downstream San MH	1860	towards upstream San MH	1859	16.29	
Distance from downstream Stm MH	-	towards upstream Stm MH	-		

Power	Size	Communications	Size	Cable	Size	Gas	Size
BC Hydro	-	Telus	-	Shaw	-	FortisBC	-
Underground Service		Underground Service		Underground Service			

Installed by:	City of Prince George forces	Survey Date:	-
Comments:			

NOT TO SCALE The information contained herein is for internal use only.
Not to be relied on unless confirmed by site inspection and/or investigation.

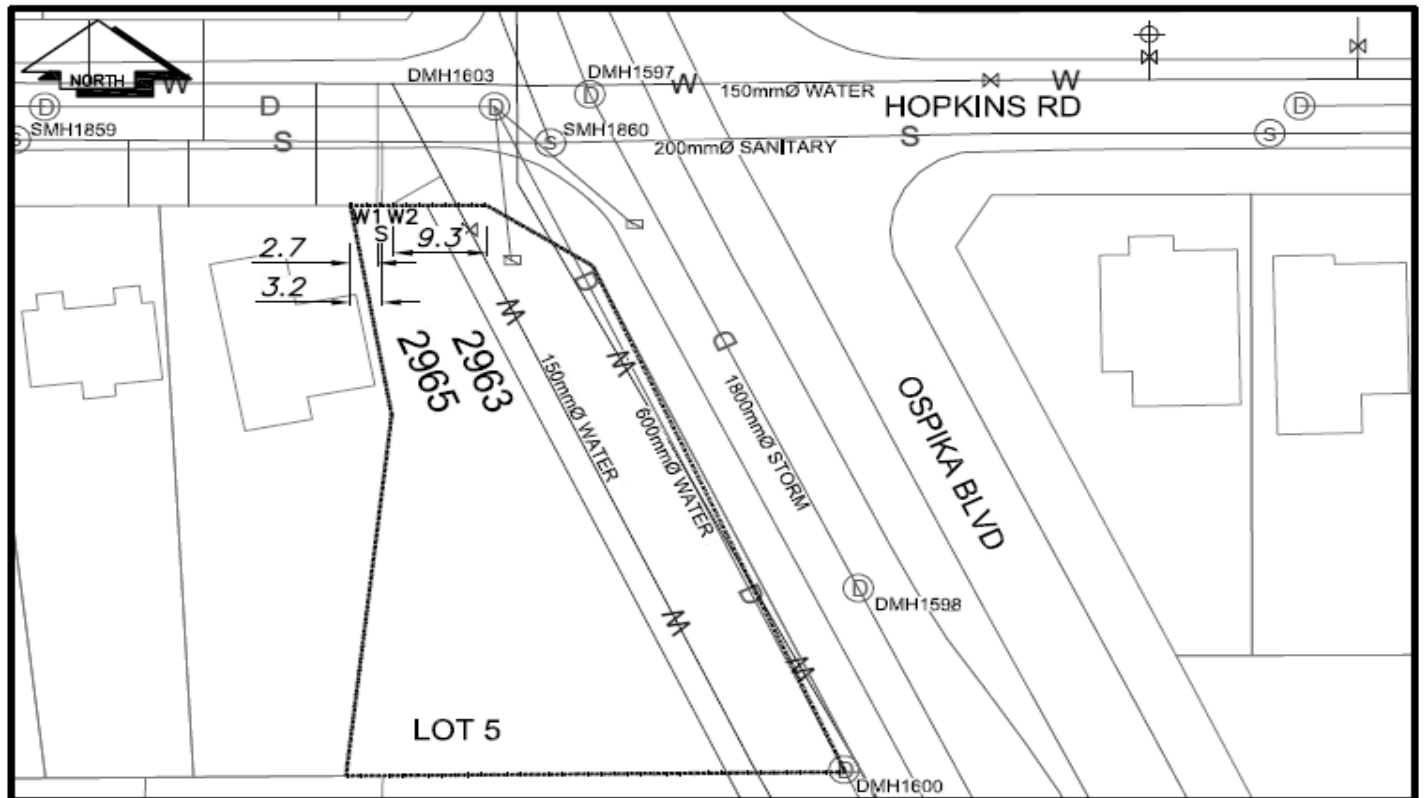

LEGEND:

CS CURB STOP	— W — WATER SERVICE	— S — SANITARY SERVICE	— G — GAS
CO CLEAN OUT	- - - - - FIRE HYDRANT	— S — ENCUMBERANCE	
⊗ WATER VALVE			

NOT TO SCALE