


5

City of Prince George Lot History Sheet

PID	Civic Address	Lot	Block	Plan	DL	Free Legal
005356857	2860 GOGOLIN RD	15	30304	1433		

	Size (mm)	Material	Invert @ PL	Cut @ PL	Survey Date	Field Book	Location	Comments
Sanitary	100φ	AC		2.74m				CONN # 11340
Water	20φ	CU						
Storm								

Accuracy Not Guaranteed Unless Confirmed By Site Inspection and/or Investigation.
Sketch is Oriented North (NTS)

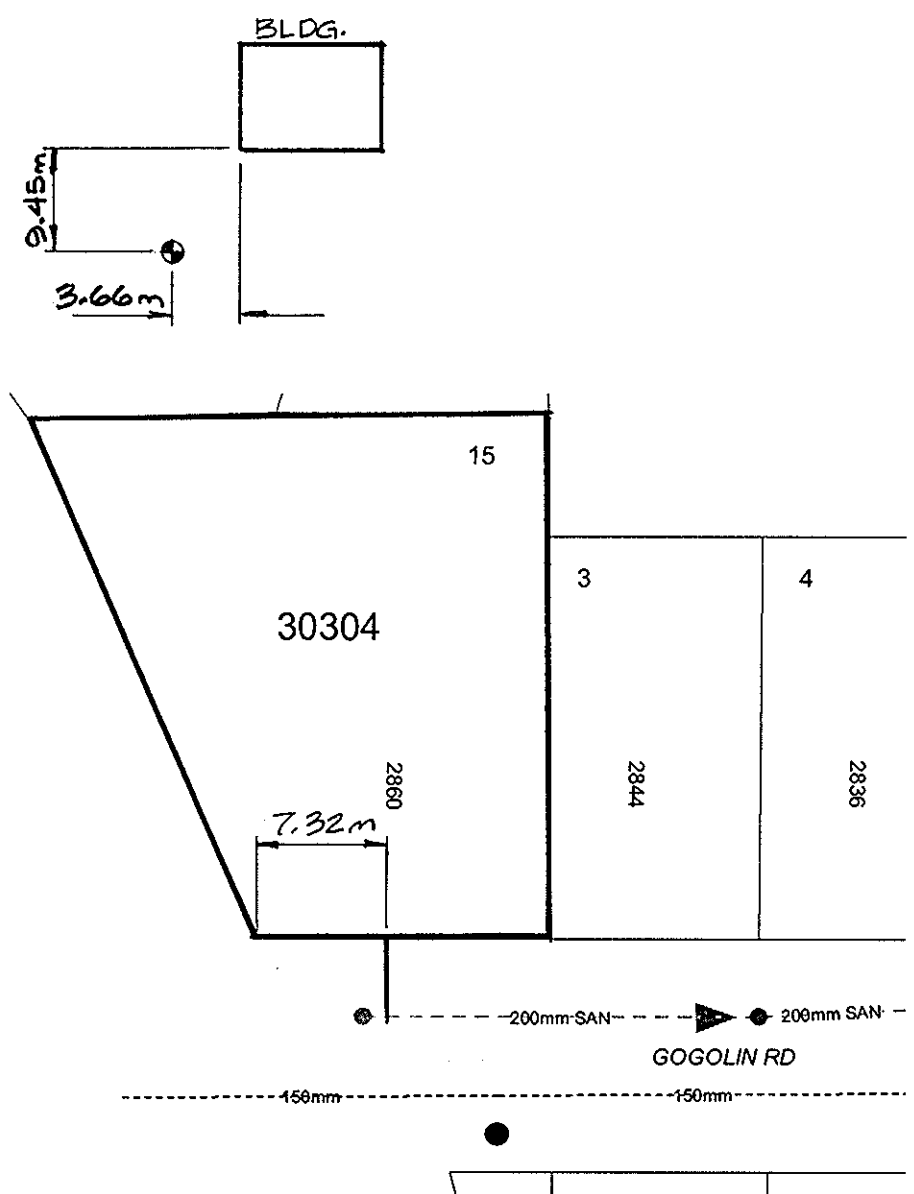

MAKE