

**City of Prince George
HISTORY SHEET**

JK

SHEET NUMBER

Roll Number 005388503

Legal: LOT'S 14 BLOCK — D.L. 934 PLAN 21226

Address: 1439 McCullagh Ave

Sanitary Connection: # 9562 SIZE 100mm MATERIAL A.C. INV. CONNECTED

Water Connection # 9562 SIZE 20mm MATERIAL COPPER METER CONNECTED

Storm Connection: # SIZE MATERIAL INV. CONNECTED

Cash Receipt No's: WATER SANITARY STORM

CURB FROM PROPERTY LINE 7.010 m PAVEMENT WIDTH 10.363 m

B.C. HYDRO O/H UNDERGROUND CONNECTION


B.C. TELEPHONE O/H UNDERGROUND CONNECTION

INLAND GAS AS SHOWN

Information Sheets:

Comments:

**THE INFORMATION CONTAINED HEREIN IS FOR INTERNAL USE ONLY.
NOT TO BE RELIED UPON UNLESS CONFIRMED BY SITE INSPECTION AND/OR INVESTIGATION**

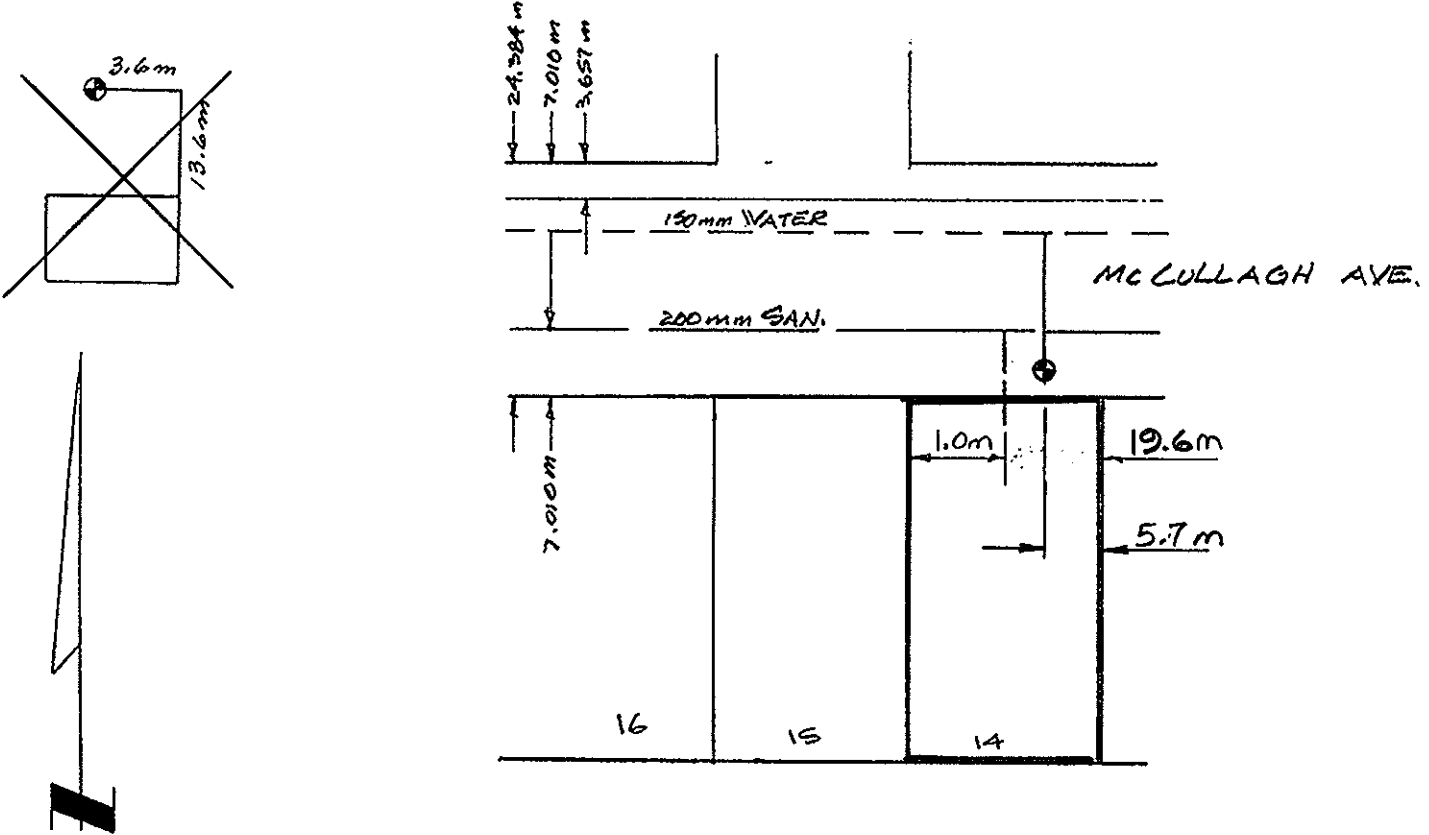

NOTE: THIS IS A COPY OF THE ORIGINAL HISTORY SHEET WHICH WAS MISPLACED.