

**City of Prince George  
HISTORY SHEET**

007809009  
015

HM

SHEET NUMBER **N<sup>o</sup> 2289** Roll Number

**Legal:** LOT'S **B-13-14** BLOCK **6** D.L. **937** PLAN **752**

**Address:** **706 IRWIN STREET**

**Sanitary Connection:** # **1967** SIZE **100mm** MATERIAL \_\_\_\_\_ INV. \_\_\_\_\_ **CONNECTED**

**Water Connection** # **949** SIZE **20mm** MATERIAL \_\_\_\_\_ METER \_\_\_\_\_ **CONNECTED**

**Storm Connection:** # \_\_\_\_\_ SIZE \_\_\_\_\_ MATERIAL \_\_\_\_\_ INV. \_\_\_\_\_ **CONNECTED**

**Cash Receipt No's:** WATER \_\_\_\_\_ SANITARY **385** STORM \_\_\_\_\_

CURB FROM PROPERTY LINE **9.877m** PAVEMENT WIDTH \_\_\_\_\_


B.C. HYDRO **OVERHEAD** UNDERGROUND CONNECTION \_\_\_\_\_

B.C. TELEPHONE **OVERHEAD** UNDERGROUND CONNECTION \_\_\_\_\_

INLAND GAS \_\_\_\_\_

**Information Sheets:**

**Comments:**

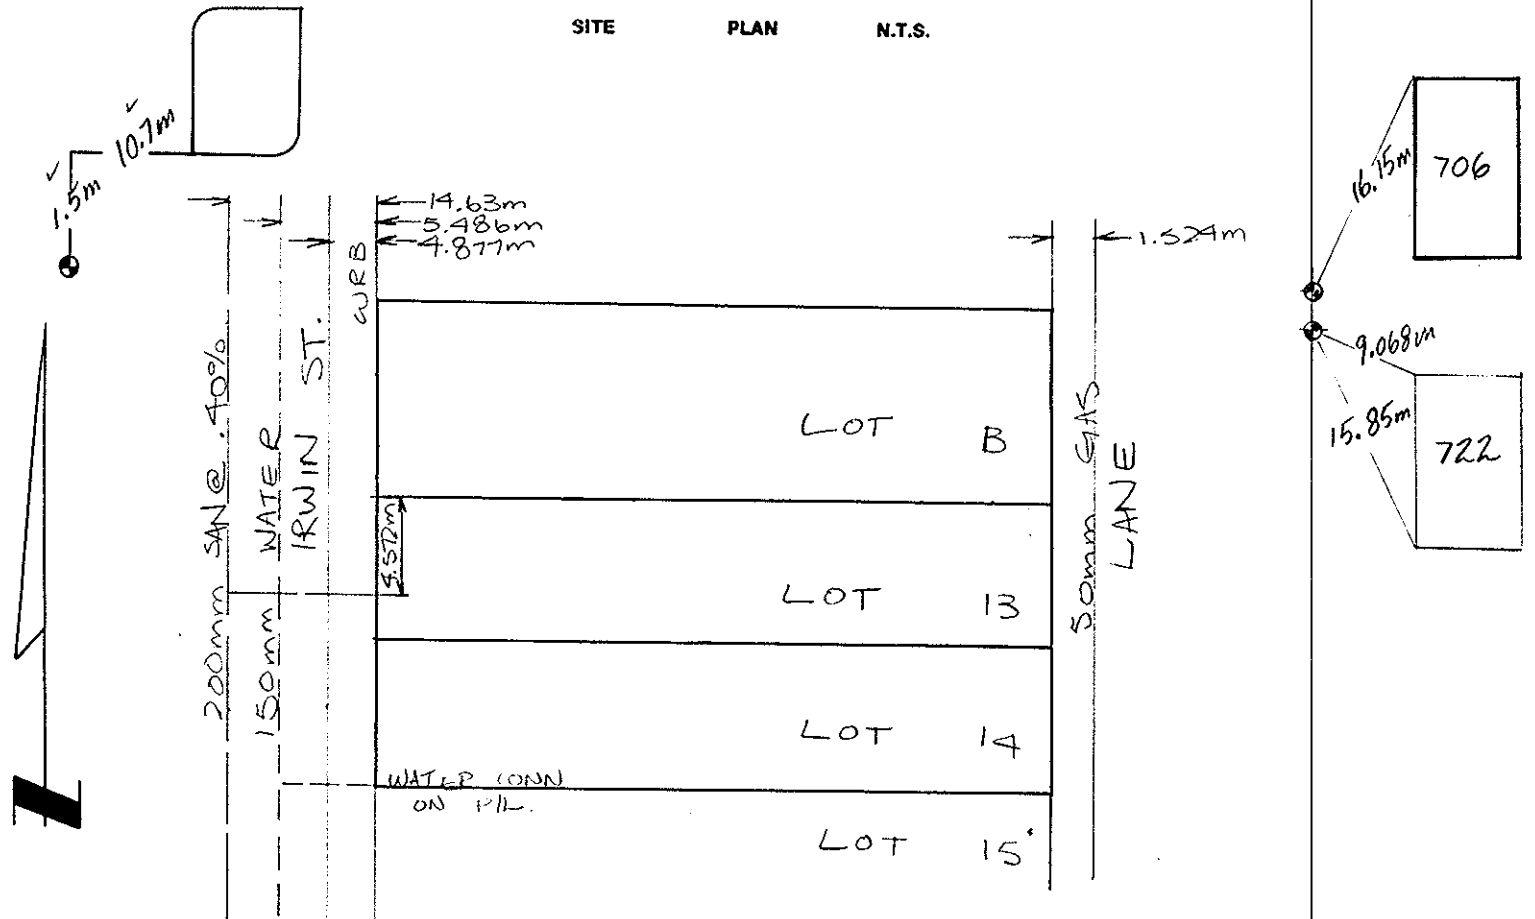

007807007

# REPORT TO RECORDS

## WATER SERVICE INFORMATION

Lot No. \_\_\_\_\_ Block \_\_\_\_\_ D.L. \_\_\_\_\_


Address 706 Irwin

Size of Connection  1/2"  3/4"  Other \_\_\_\_\_

Type of Connection  Copper  Iron

Thaw Wire  Yes  No

### LOCATION SKETCH

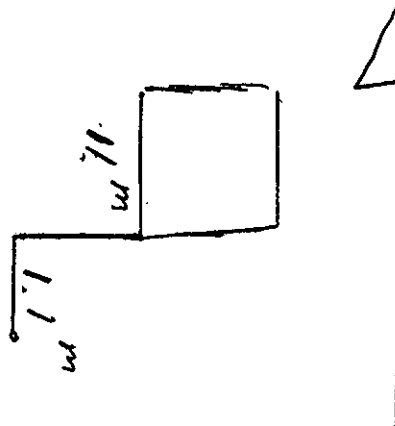

Field Location By G.C. Date 6/8/92

Checked by: \_\_\_\_\_