

**City of Prince George  
HISTORY SHEET**

305502/95HM

SHEET NUMBER

Roll Number

209

Legal: LOT'S 9-10 BLOCK 67 D.L. 937 PLAN 752

Address: 329 IRWIN ST.

Sanitary Connection: # 2792 SIZE 100mm MATERIAL A.C. INV. 596.191 CONNECTED 1968

Water Connection # 1800 SIZE 13mm MATERIAL CU METER CONNECTED

Storm Connection: # \_\_\_\_\_ SIZE \_\_\_\_\_ MATERIAL \_\_\_\_\_ INV. \_\_\_\_\_ CONNECTED

Cash Receipt No's: WATER \_\_\_\_\_ SANITARY 190 STORM \_\_\_\_\_

CURB FROM PROPERTY LINE 4.877 m PAVEMENT WIDTH 10.363 m


B.C. HYDRO 0/H IN LANE UNDERGROUND CONNECTION \_\_\_\_\_

B.C. TELEPHONE 0/H IN LANE UNDERGROUND CONNECTION \_\_\_\_\_

INLAND GAS IN LANE AS SHOWN

Information Sheets: \_\_\_\_\_  
 Comments: \_\_\_\_\_

**THE INFORMATION CONTAINED HEREIN IS FOR INTERNAL USE ONLY. NOT TO BE RELIED UPON UNLESS CONFIRMED BY SITE INSPECTION AND/OR INVESTIGATION.**

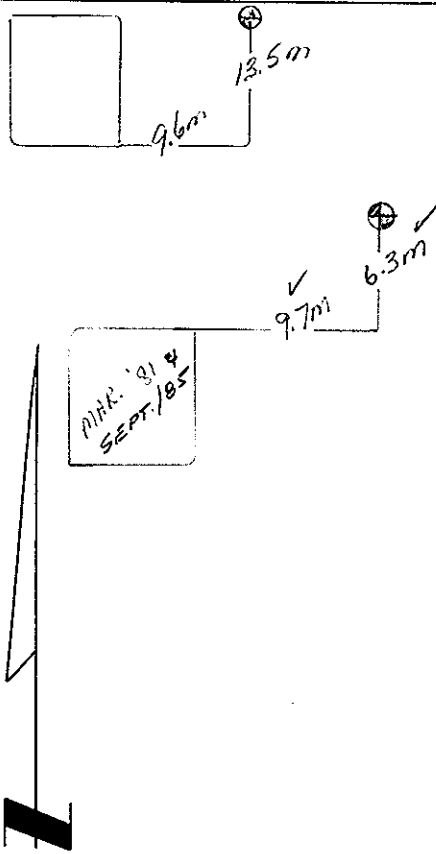

SITE PLAN N.T.S.

