

**City of Prince George
HISTORY SHEET**

305502/95HM

SHEET NUMBER

Roll Number

209

Legal: LOT'S 9-10 BLOCK 67 D.L. 937 PLAN 752

Address: 329 IRWIN ST.

Sanitary Connection: # 2702 SIZE 100mm MATERIAL A.C. INV. 536.191 CONNECTED 1968

Water Connection # 1800 SIZE 13mm MATERIAL CU. METER CONNECTED

Storm Connection: # SIZE MATERIAL INV. CONNECTED

Cash Receipt No's: WATER SANITARY 190 STORM

CURB FROM PROPERTY LINE 4.877 m PAVEMENT WIDTH 10.363 m


B.C. HYDRO 0/H IN LANE UNDERGROUND CONNECTION

B.C. TELEPHONE 0/H IN LANE UNDERGROUND CONNECTION

INLAND GAS IN LANE AS SHOWN

Information Sheets: THE INFORMATION CONTAINED HEREIN IS FOR INTERNAL

Comments: USE ONLY. NOT TO BE RELIED UPON UNLESS CONFIRMED BY SITE INSPECTION AND/OR INVESTIGATION.

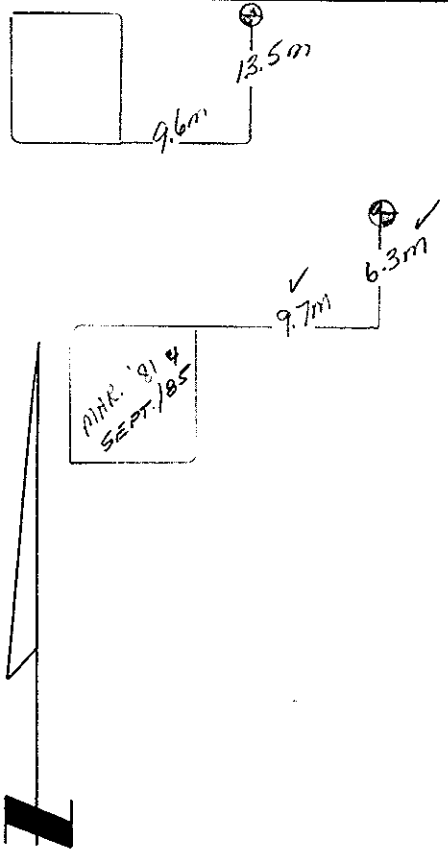

SITE PLAN N.T.S.

