

**City of Prince George
HISTORY SHEET**

005502014

SHEET NUMBER

Roll Number

Legal: LOT'S 27 BLOCK 5 D.L. 932 PLAN 796

Address: 2129 QUINCE ST.

Sanitary Connection: # 7764 SIZE 100mm MATERIAL A.C. INV. 567.417 CONNECTED

Water Connection # 7782 SIZE 20mm MATERIAL C.U. METER CONNECTED

Storm Connection: # _____ SIZE _____ MATERIAL _____ INV. _____ CONNECTED

Cash Receipt No's: WATER _____ SANITARY 330 STORM _____

CURB FROM PROPERTY LINE 4.877 m PAVEMENT WIDTH 10.363 m

B.C. HYDRO 0/H UNDERGROUND CONNECTION _____



B.C. TELEPHONE 0/H UNDERGROUND CONNECTION _____

INLAND GAS 3.657m FROM R

Information Sheets:

Comments: WITH THAW WIRE.; JUMP TO 2135 QUINCE;

**THE INFORMATION CONTAINED HEREIN IS FOR INTERNAL USE ONLY.
NOT TO BE RELIED UPON UNLESS CONFIRMED BY SITE INSPECTION AND/OR INVESTIGATION**

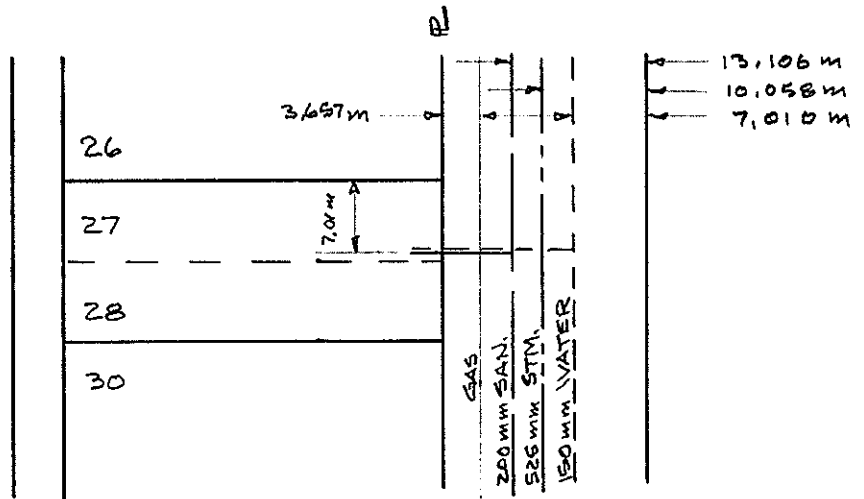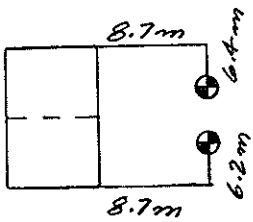

QUINCE ST.

