

**City of Prince George  
HISTORY SHEET**

005509718

SHEET NUMBER **No 3869** Roll Number

Legal: LOT'S **14** BLOCK D.L. ~~4041~~ **4040** PLAN **28286**

Address: **1989 CLEARWOOD CRES.**

Sanitary Connection: # SIZE **4"** MATERIAL **P.V.C.** INV. **2149.70** CONNECTED

Water Connection # SIZE **3/4"** MATERIAL **Cu** METER CONNECTED

Storm Connection: # SIZE MATERIAL INV. CONNECTED

Cash Receipt No's: WATER SANITARY STORM

CURB FROM PROPERTY LINE **16'** (Roll Curb) PAVEMENT WIDTH **34'**

B.C. HYDRO UNDERGROUND CONNECTION **U/G Midlot**

B.C. TELEPHONE UNDERGROUND CONNECTION **U/G Midlot**

INLAND GAS


Information Sheets:

Comments: **Bench mark elevation 2123.850, hydrant**

Direction arrow N.W. corner Bellamy and Clearwood

~~The information contained herein is for internal use only. Not to be relied upon unless confirmed by site inspection and/or investigation.~~

PLAN N.T.S.

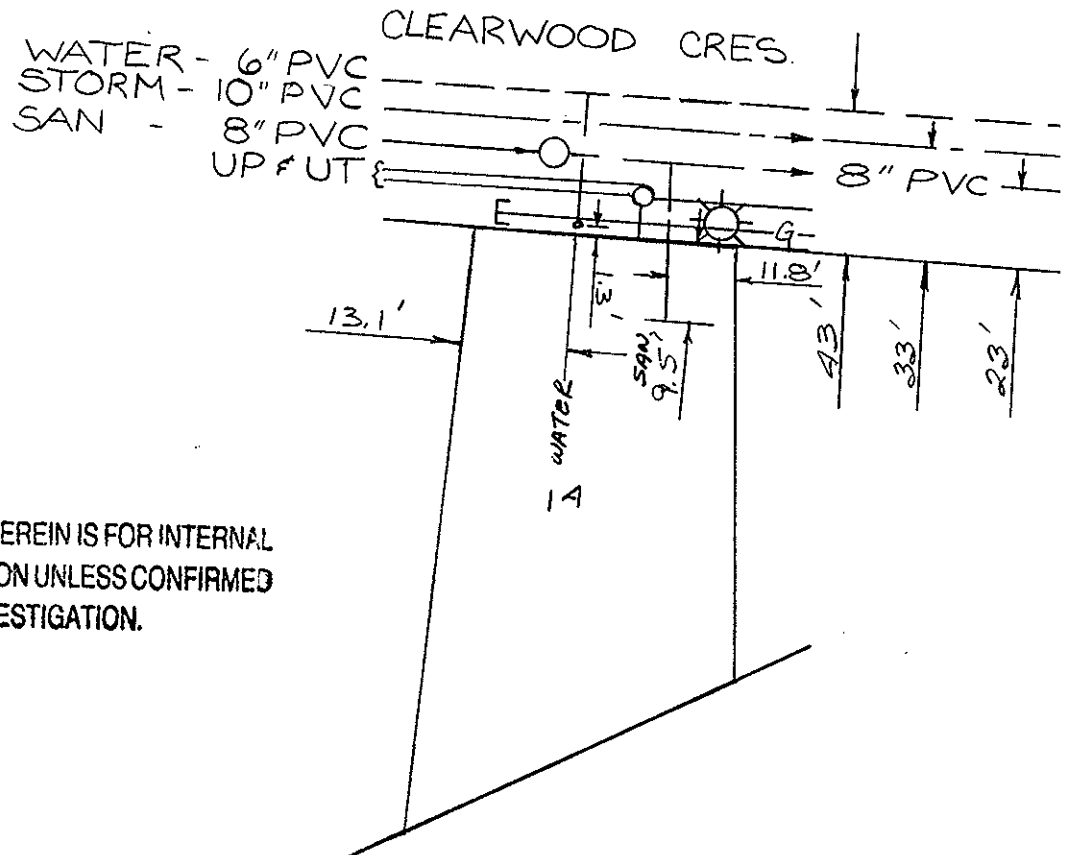

THE INFORMATION CONTAINED HEREIN IS FOR INTERNAL USE ONLY. NOT TO BE RELIED UPON UNLESS CONFIRMED BY SITE INSPECTION AND/OR INVESTIGATION.