

# City of Prince George HISTORY SHEET

SHEET NUMBER **Nº 1479** Roll Number **005534038**

Legal: LOT'S **8** BLOCK **4047** PLAN **3001**

Address: **6968 DAGG ROAD**

Sanitary Connection: # **15199** SIZE **100mm** MATERIAL **PVC** INV. **CONNECTED**

Water Connection # **15199** SIZE **20mm** MATERIAL **Cu** METER **CONNECTED**

Storm Connection: #  SIZE  MATERIAL  INV. **CONNECTED**

Cash Receipt No's: WATER **614** SANITARY **615** STORM

CURB FROM PROPERTY LINE  PAVEMENT WIDTH


B.C. HYDRO  UNDERGROUND CONNECTION

B.C. TELEPHONE  UNDERGROUND CONNECTION

INLAND GAS

Information Sheets:  THE INFORMATION CONTAINED HEREIN IS FOR INTERNAL USE ONLY. NOT TO BE RELIED UPON UNLESS CONFIRMED BY SITE INSPECTION AND/OR INVESTIGATION.

Comments:

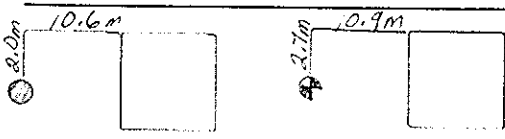

SITE PLAN N.T.S.

