

City of Prince George HISTORY SHEET

SHEET NUMBER

Roll Number 305566 550

Legal: LOT'S 22

BLOCK

D.L. 745

PLAN 29100

Address:

Sanitary Connection: # SIZE 100 mm MATERIAL P.V.C. INV. 593.15 CONNECTED

Water Connection # SIZE 25 mm MATERIAL COPPER METER CONNECTED

Storm Connection: # SIZE 150 mm MATERIAL P.V.C. INV. 593.78 CONNECTED

Cash Receipt No's: WATER SANITARY STORM

CURB FROM PROPERTY LINE 3.5 m ROLL CURB PAVEMENT WIDTH 13.0 m

B.C. HYDRO UNDERGROUND CONNECTION


B.C. TELEPHONE UNDERGROUND CONNECTION

INLAND GAS

Information Sheets:

Comments: CITY B.M. # 774-73 H.N. WEST SIDE OF PACIFIC &
SOUTH OF TERMINAL EL. 595.364

THE INFORMATION CONTAINED HEREIN IS FOR INTER-OFFICE USE ONLY. NOT TO BE RELIED UPON UNLESS CONFIRMED BY SITE INSPECTION AND/OR INVESTIGATION.

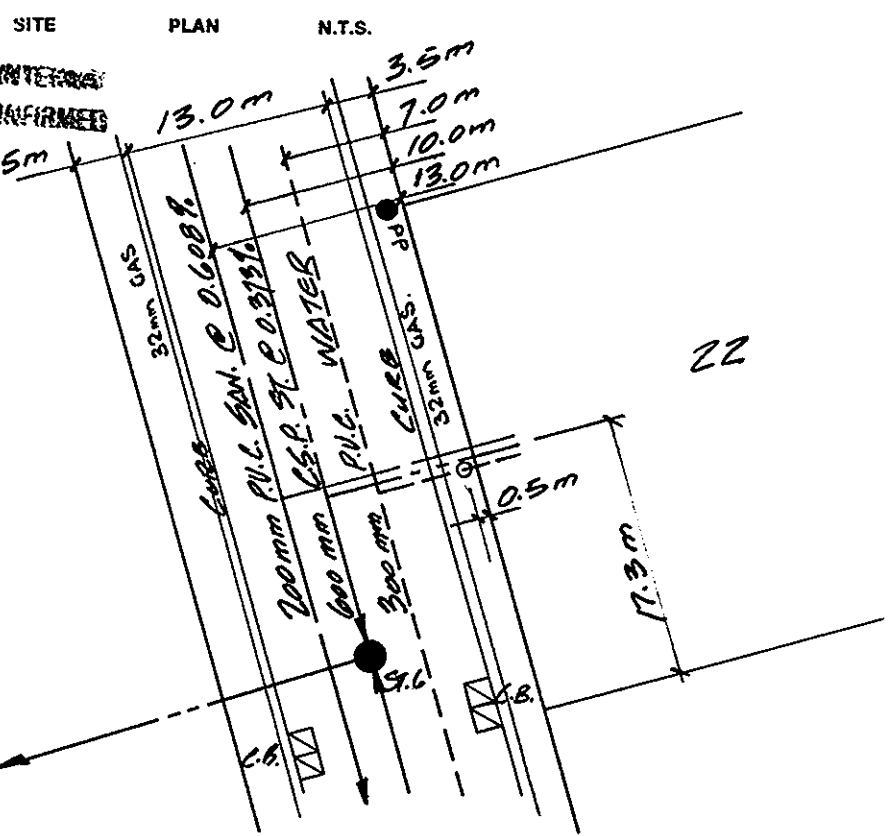

22