

City of Prince George HISTORY SHEET

SHEET NUMBER

Roll Number 005566576

Legal: LOT'S 21 BLOCK D.L. 745 PLAN 29/00

Address: 4870 CONTINENTAL WAY

Sanitary Connection: # SIZE 100mm MATERIAL P.V.C. INV. 593.39 CONNECTED

Water Connection # SIZE 25mm MATERIAL COPPER METER CONNECTED

Storm Connection: # SIZE 150mm MATERIAL P.V.C. INV. 594.15 CONNECTED

Cash Receipt No's: WATER SANITARY STORM

CURB FROM PROPERTY LINE 3.5m ROLL CURB PAVEMENT WIDTH 13.0m

B.C. HYDRO UNDERGROUND CONNECTION


B.C. TELEPHONE UNDERGROUND CONNECTION

INLAND GAS

Information Sheets:

Comments: CITY B.M. #774-73 H.N. WEST SIDE OF PACIFIC & SOUTH
OF TERMINAL EL. 595.364
3.4 M NORTH OF S.W. CORNER & 4.5 M EAST S.C/O

THE INFORMATION CONTAINED HEREIN IS FOR INTERNAL USE ONLY. NOT TO BE RELIED UPON UNLESS CONFIRMED BY SITE INSPECTION AND/OR INVESTIGATION.

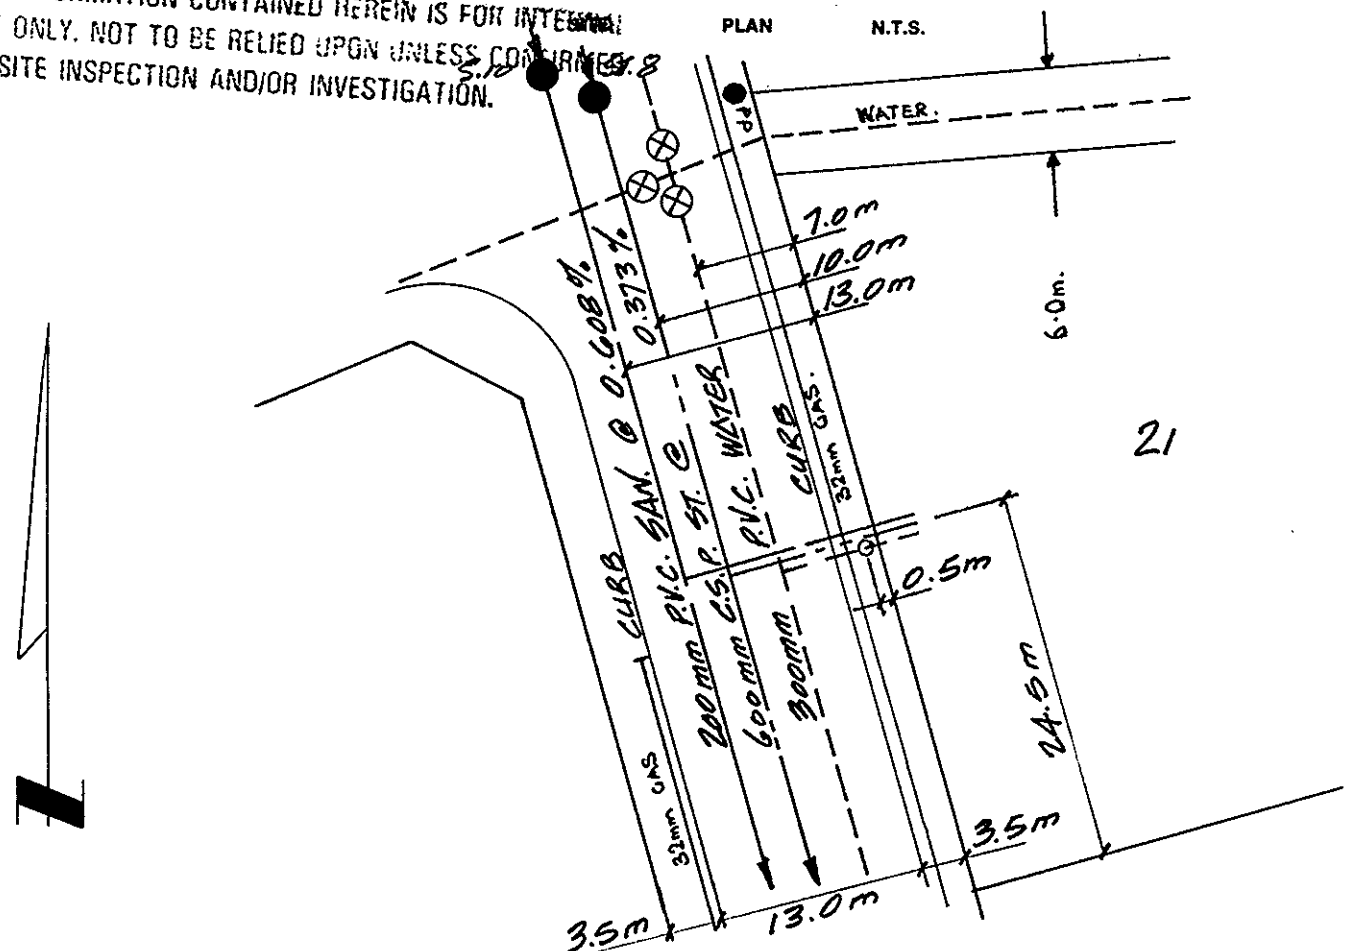

21