


## Lot Servicing

**220 FORT ST**

**PID: 005569982**

**Lot: 16, Block: 10, Plan: 1268, DL: 343**

SERVICE	SIZE	MATERIAL	INSTALLED DATE	LOCATION	DETAILS
WATER	40MM	CU	30-Aug-2006	LOT 16 - 6.7M N AND 5.6M E OF NW CORNER BLDG	CASH RECEIPT NUMBER 100528
SANITARY	100MM	PVC	30-Aug-2006	LOT 16 - 2.7M N AND 6.3M E OF NW CORNER BLDG	CLEANOUT Y

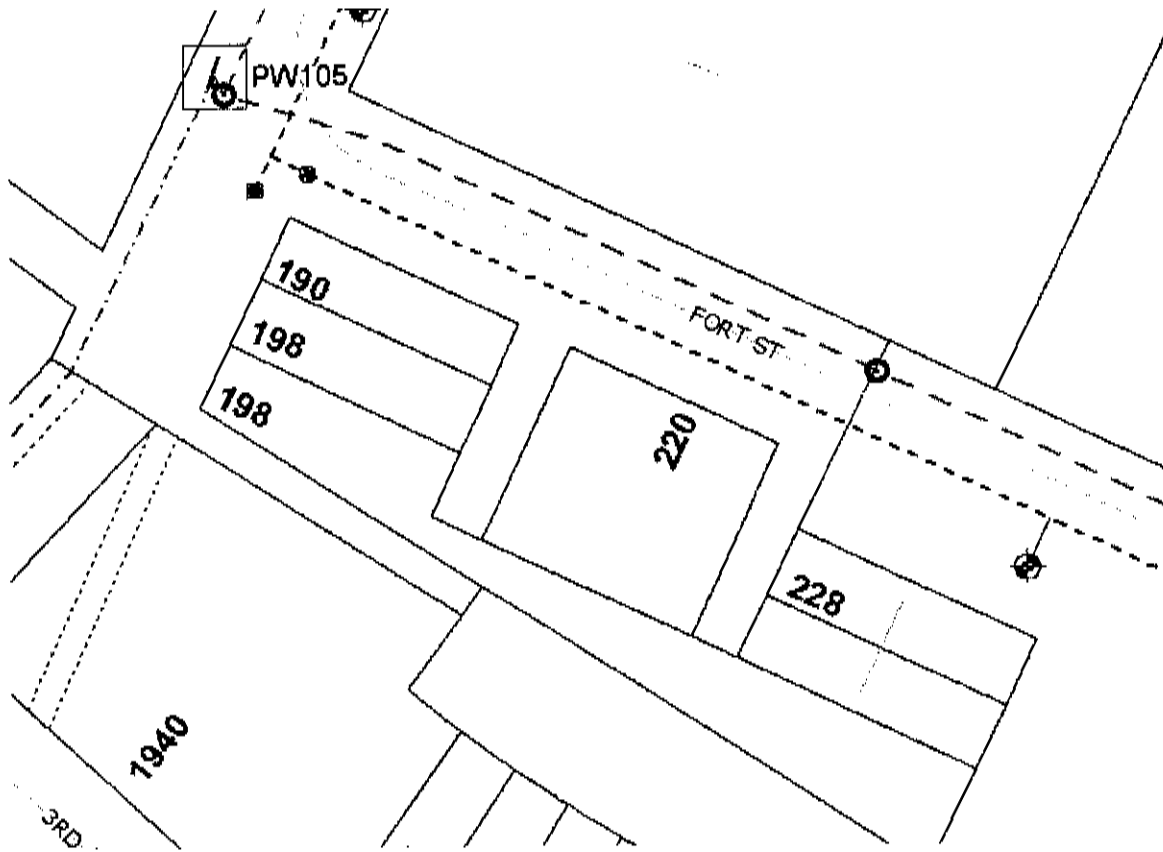

Accuracy not guaranteed unless confirmed by site inspection and/or investigation.  
Connection location between main and property line only.