

**City of Prince George
HISTORY SHEET**

245
229

SHEET NUMBER

Roll Number

Legal: LOT'S 30-32 BLOCK 10 D.L. 932 PLAN 796

Address: 2219-2217 PINE STREET

Sanitary Connection: # 6660 SIZE 100mm MATERIAL A.C. INV. 566.862 CONNECTED

Water Connection # 6660 SIZE 20mm MATERIAL C.U. METER CONNECTED

Storm Connection: # SIZE MATERIAL INV. CONNECTED

Cash Receipt No's: WATER SANITARY 101 STORM

CURB FROM PROPERTY LINE 5.791 m PAVEMENT WIDTH 12.801 m

B.C. HYDRO 0/H UNDERGROUND CONNECTION



B.C. TELEPHONE 0/H UNDERGROUND CONNECTION

INLAND GAS 4.572 m FROM EAST SIDE OF PINE ST.

Information Sheets:

Comments: WITH THAW WIRE.

SITE PLAN N.T.S.

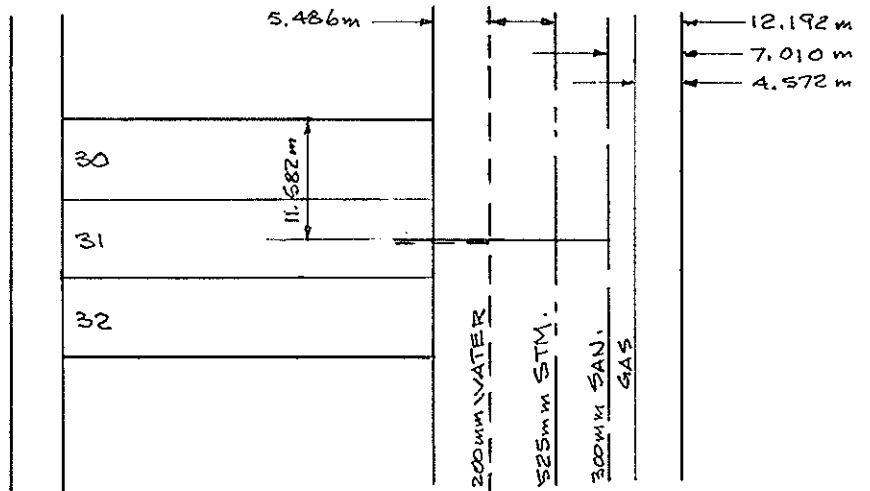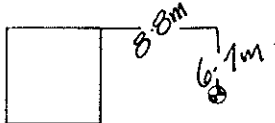

PINE ST.