


City of Prince George HISTORY SHEET

SHEET NUMBER		Roll Number <u>035620101</u>			
Legal:	LOT'S <u>4</u>	BLOCK	D.L. <u>633</u>	PLAN	<u>29-98</u>
Address: <u>1002 N. Blackburn Rd.</u>					
Sanitary Connection:	# <u>16367</u>	SIZE <u>100MM</u>	MATERIAL <u>PVC</u>	INV.	CONNECTED
Water Connection:	# <u>16367</u>	SIZE <u>80MM</u>	MATERIAL <u>Copper</u>	METER	CONNECTED
Storm Connection:	#	SIZE	MATERIAL	INV.	CONNECTED
Cash Receipt No's:	WATER <u>0170</u>	SANITARY	<u>0171</u>	STORM	
CURB FROM PROPERTY LINE			PAVEMENT WIDTH		
B.C. HYDRO			UNDERGROUND CONNECTION		
B.C. TELEPHONE			UNDERGROUND CONNECTION		
INLAND GAS					
Information Sheets:			THE INFORMATION CONTAINED HEREIN IS FOR INTERNAL USE ONLY. NOT TO BE RELIED UPON UNLESS CONFIRMED BY SITE INSPECTION AND/OR INVESTIGATION.		
Comments:					

SITE PLAN N.T.S.

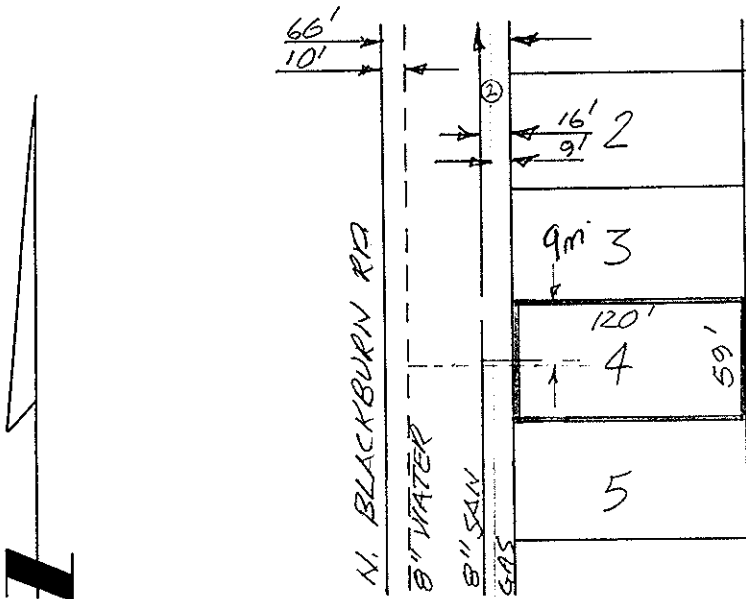

REM. LOT 8