

**City of Prince George  
HISTORY SHEET**

005629306

SHEET NUMBER **5488** Roll Number

Legal: LOT'S **26** BLOCK D.L. **4046** PLAN **26060**

Address: **2646 CARLISLE WAY**

Sanitary Connection: # SIZE **100 mm** MATERIAL **PVC** INV. **735.54** CONNECTED

Water Connection # SIZE **18 mm** MATERIAL **COPPER** METER CONNECTED

Storm Connection: # **NONE** SIZE MATERIAL INV. CONNECTED

Cash Receipt No's: WATER SANITARY STORM

CURB FROM PROPERTY LINE **OPEN DITCH** PAVEMENT WIDTH **8 m**


B.C. HYDRO UNDERGROUND CONNECTION

B.C. TELEPHONE UNDERGROUND CONNECTION

INLAND GAS

Information Sheets:

Comments: **BM: HYD. SPINDLE N/W COR. NIXON E RIDGEVIEW DR.  
ELEV. 743.712 m**

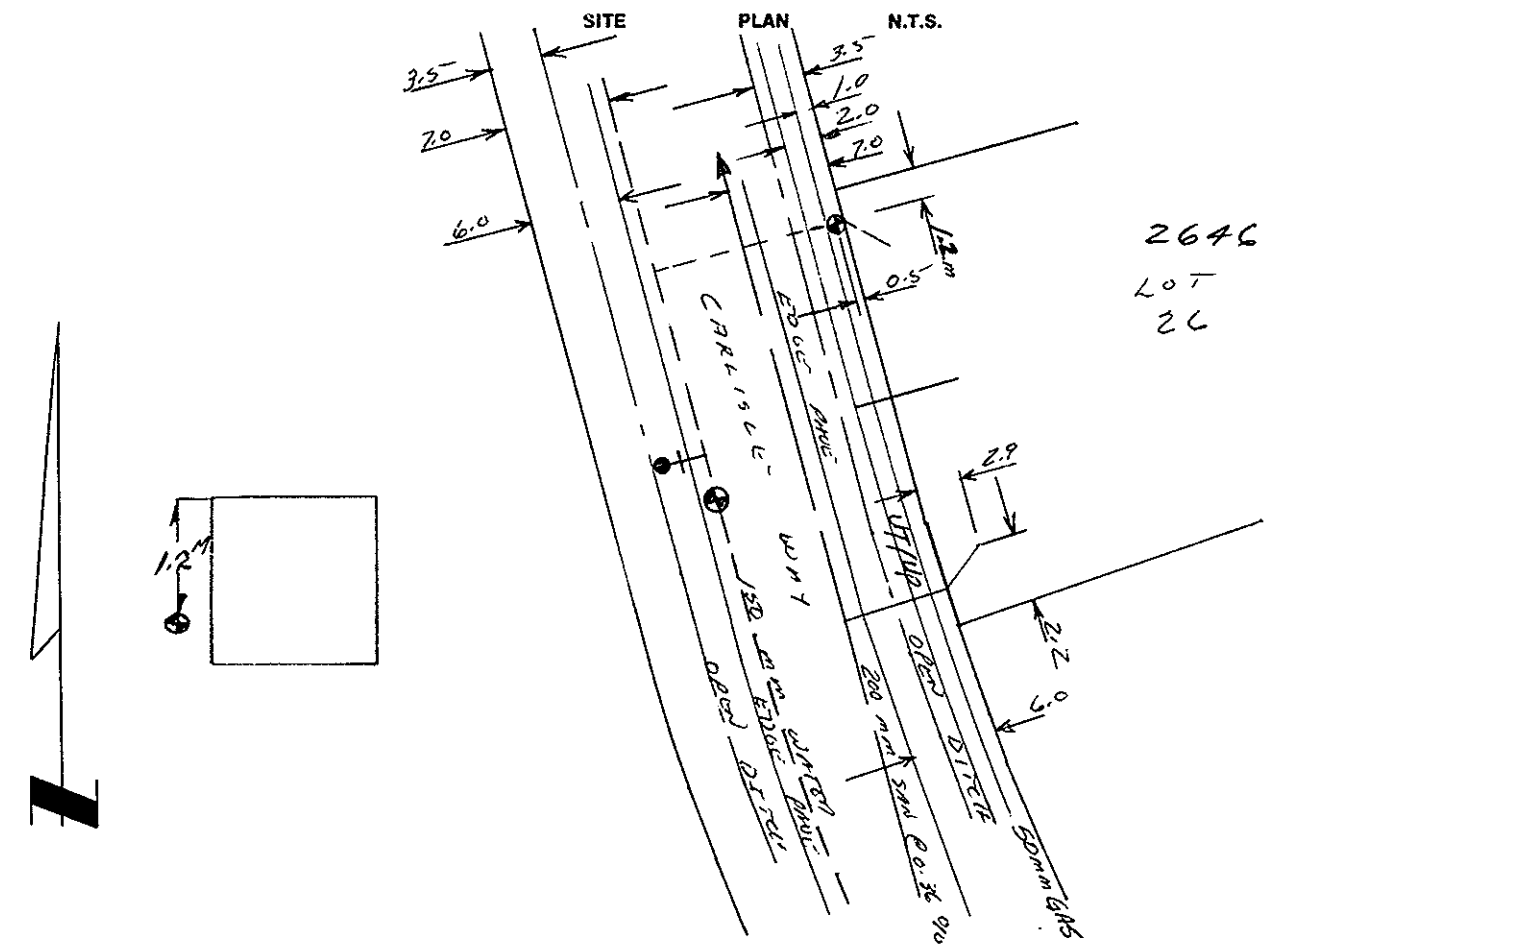

2646  
LOT  
26