

**City of Prince George
HISTORY SHEET**

SHEET NUMBER _____ Roll Number 005650 984

Legal: LOT'S 28 BLOCK _____ D.L. 2608 PLAN 20 043

Address: 4445 FIRST AVE.

Sanitary Connection: # 7337 SIZE 100 mm MATERIAL A.C. INV. _____ CONNECTED _____

Water Connection # 7337 SIZE 20 mm MATERIAL CU METER _____ CONNECTED _____

Storm Connection: # _____ SIZE _____ MATERIAL _____ INV. _____ CONNECTED _____

Cash Receipt No's: WATER _____ SANITARY _____ STORM _____

CURB FROM PROPERTY LINE 5.791 m PAVEMENT WIDTH 12.801 m

B.C. HYDRO U/G UNDERGROUND CONNECTION _____


B.C. TELEPHONE U/G UNDERGROUND CONNECTION _____

INLAND GAS AS SHOWN

Information Sheets: _____

Comments: WITH THAW WIRE;

**THE INFORMATION CONTAINED HEREIN IS FOR INTERNAL USE ONLY.
NOT TO BE RELIED UPON UNLESS CONFIRMED BY SITE INSPECTION AND/OR INVESTIGATION**

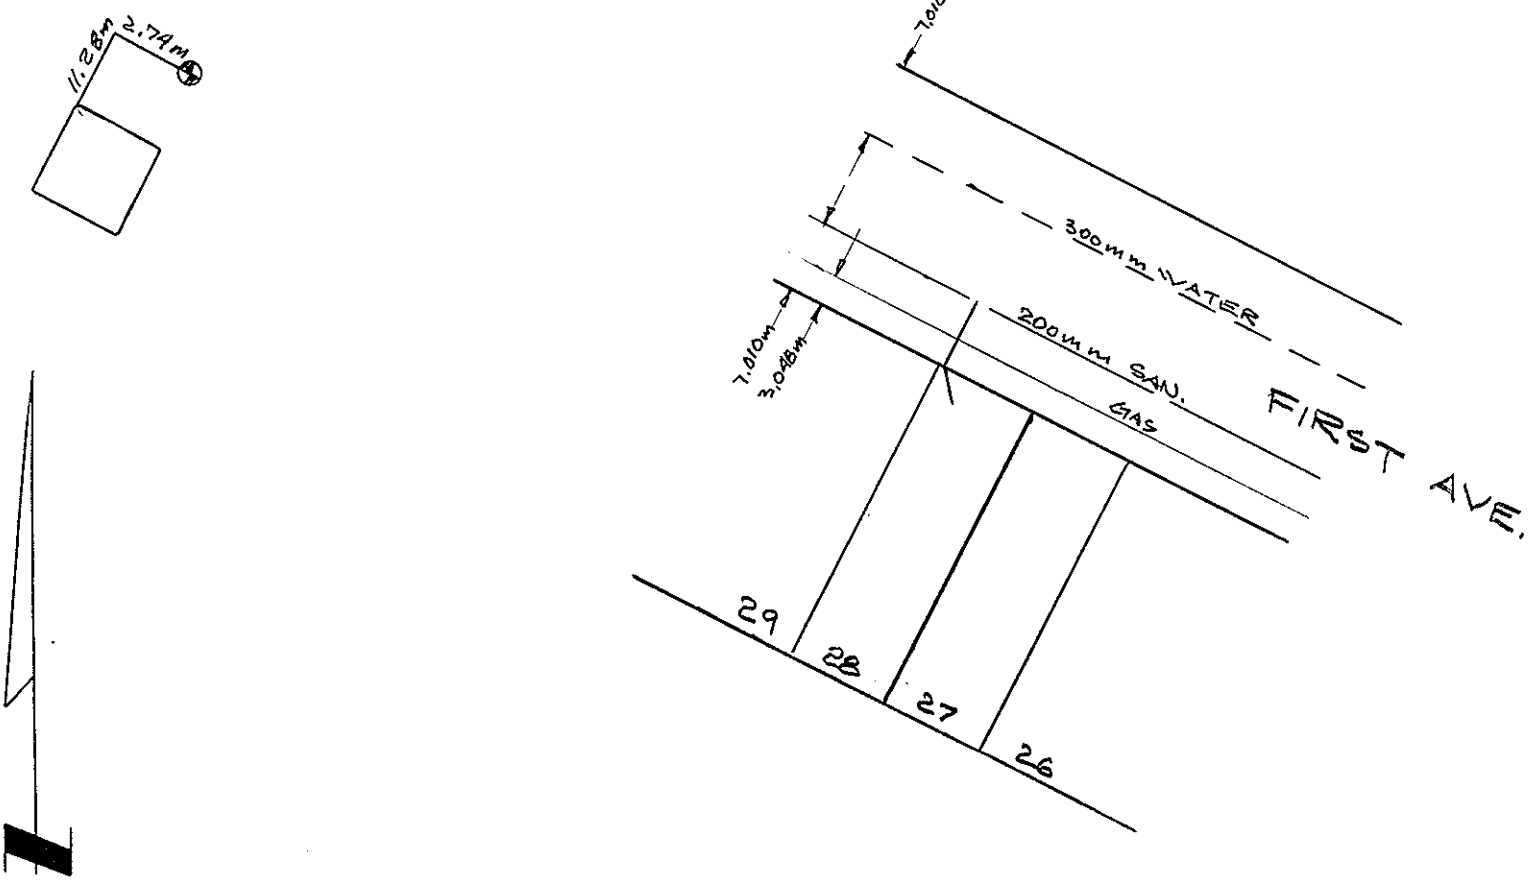

JUN 04 1987

REPORT TO RECORDS

WATER SERVICE INFORMATION

005650984

Lot No. 28 Block D.L. 2608

Address 4445 1ST AVENUE


Size of Connection 1/2" 3/4" Other _____

Type of Connection Copper Iron

Thaw Wire Yes No

PL 20043

LOCATION SKETCH

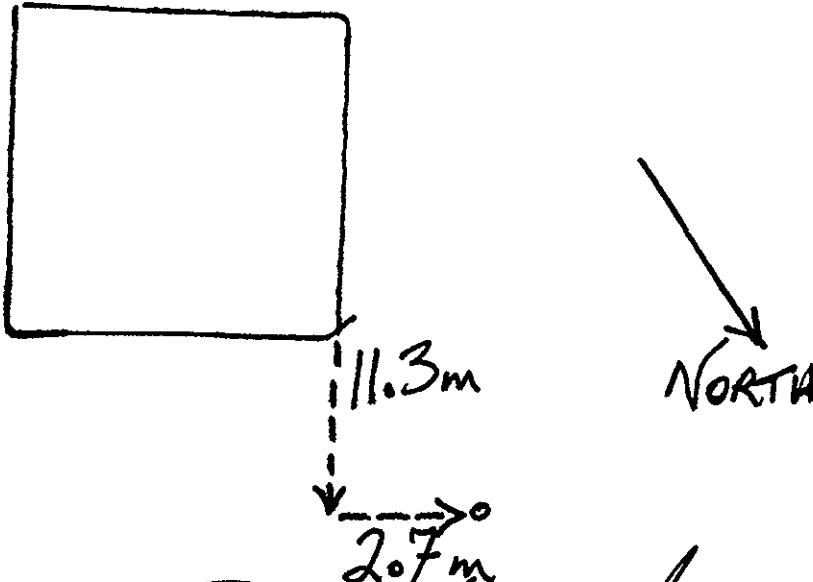

Field Location By W. Bond Date May 27, 1987

Checked by: _____