

City of Prince George HISTORY SHEET

95

SHEET NUMBER **N^o 1632** Roll Number

Legal: LOT'S **A** BLOCK **4043** D.L. **SD. 11-3** PLAN

Address: **WEST AUSTIN RD.**

Sanitary Connection: # SIZE **100mm** MATERIAL INV. **700.740m** CONNECTED

Water Connection # SIZE **20mm** MATERIAL METER CONNECTED

Storm Connection: # SIZE MATERIAL INV. CONNECTED

Cash Receipt No's: WATER SANITARY STORM

CURB FROM PROPERTY LINE PAVEMENT WIDTH


B.C. HYDRO UNDERGROUND CONNECTION

B.C. TELEPHONE UNDERGROUND CONNECTION

INLAND GAS

Information Sheets:

Comments:

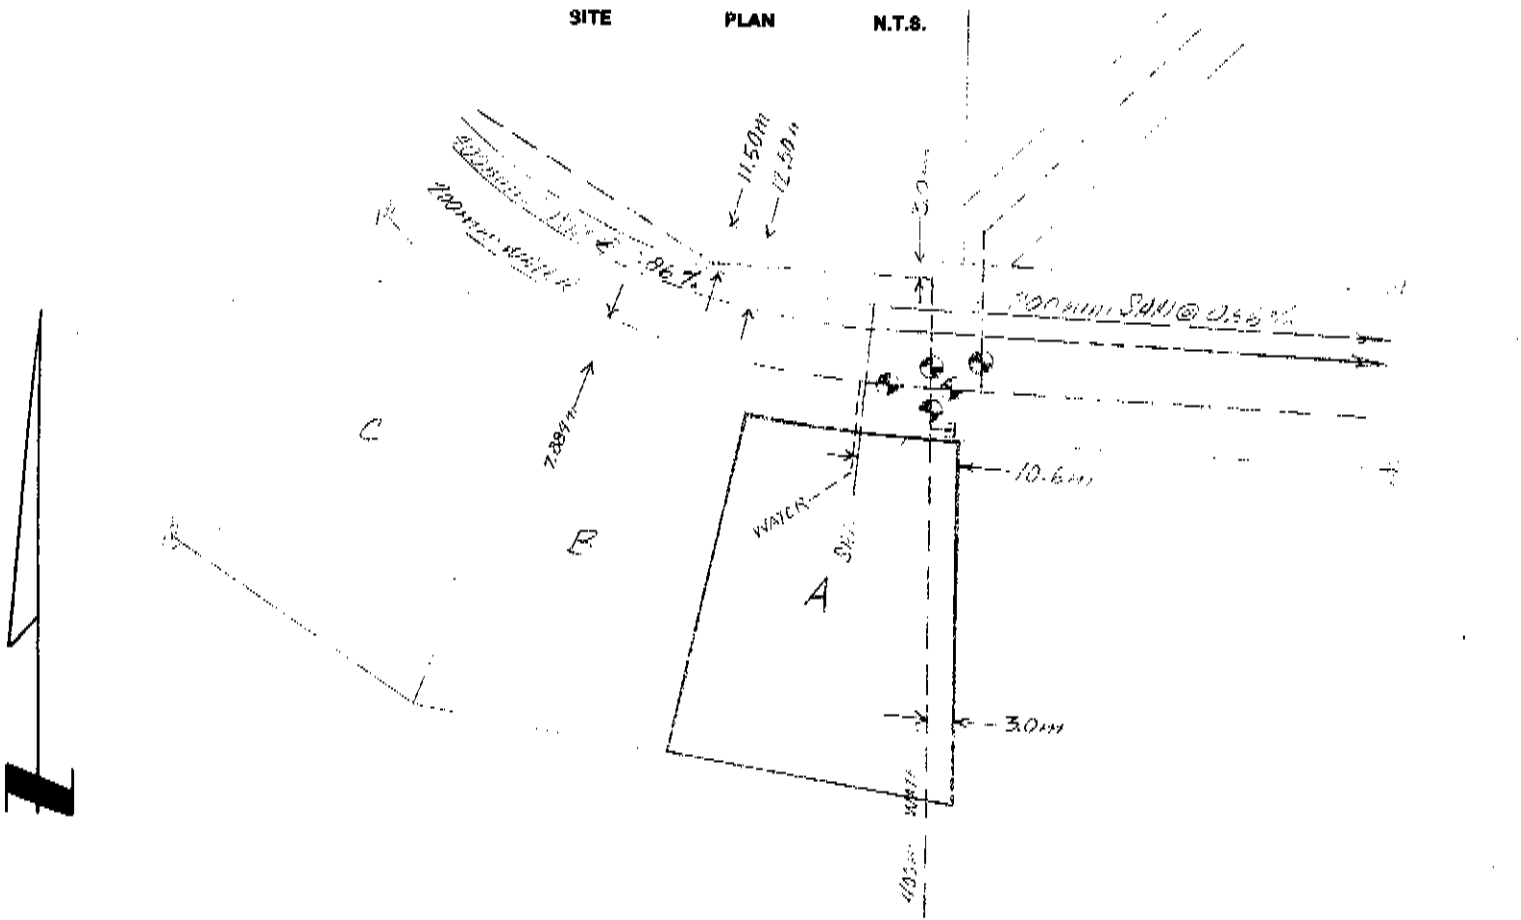

**City of Prince George
HISTORY SHEET**

D S

SHEET NUMBER **Nº 1633** Roll Number

Legal: LOT'S **B** BLOCK D.L. **4048** PLAN **SD 1153**

Address: **WEST AUSTON RD.**

Sanitary Connection: # SIZE **100 mm** MATERIAL INV. **766.312m** CONNECTED

Water Connection # SIZE **20 mm** MATERIAL METER CONNECTED

Storm Connection: # SIZE MATERIAL INV. CONNECTED

Cash Receipt No's: WATER SANITARY STORM

CURB FROM PROPERTY LINE PAVEMENT WIDTH


B.C. HYDRO UNDERGROUND CONNECTION

B.C. TELEPHONE UNDERGROUND CONNECTION

INLAND GAS

Information Sheets:

Comments:

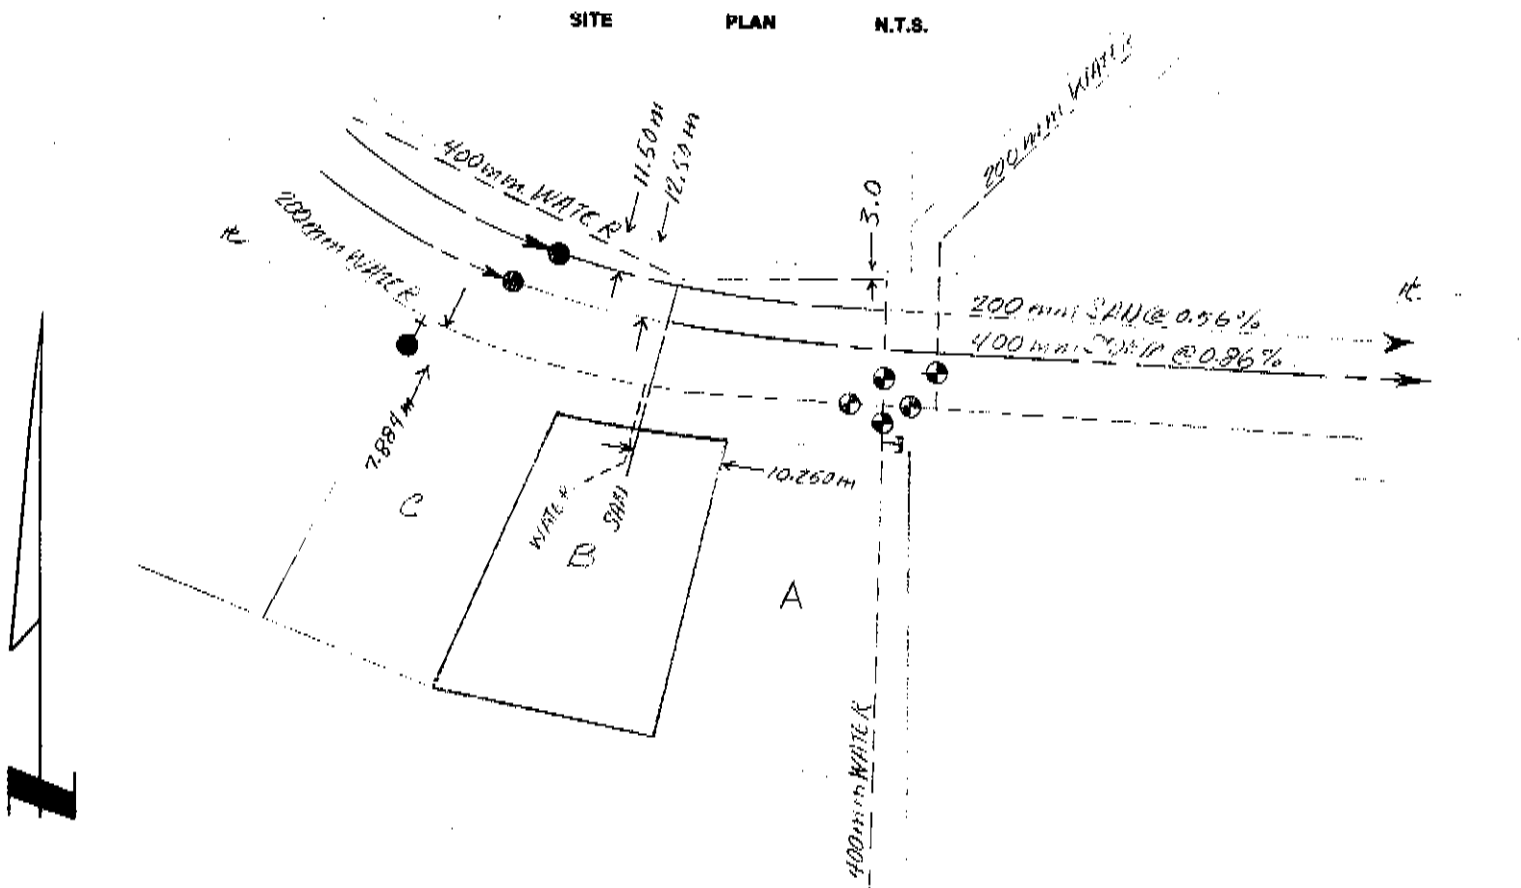

**City of Prince George
HISTORY SHEET**

D S

SHEET NUMBER **N^o 1634** Roll Number

Legal: LOT'S **C** BLOCK D.L. **4048** PLAN **S.D. 1153**

Address: **WEST AUSTIN RD.**

Sanitary Connection: # SIZE **100 MM** MATERIAL INV. **766.666M** CONNECTED

Water Connection # SIZE **20 MM** MATERIAL METER CONNECTED

Storm Connection: # SIZE MATERIAL INV. CONNECTED

Cash Receipt No's: WATER SANITARY STORM

CURB FROM PROPERTY LINE PAVEMENT WIDTH

B.C. HYDRO UNDERGROUND CONNECTION


B.C. TELEPHONE UNDERGROUND CONNECTION

INLAND GAS

Information Sheets:

Comments:

SITE PLAN N.T.S.

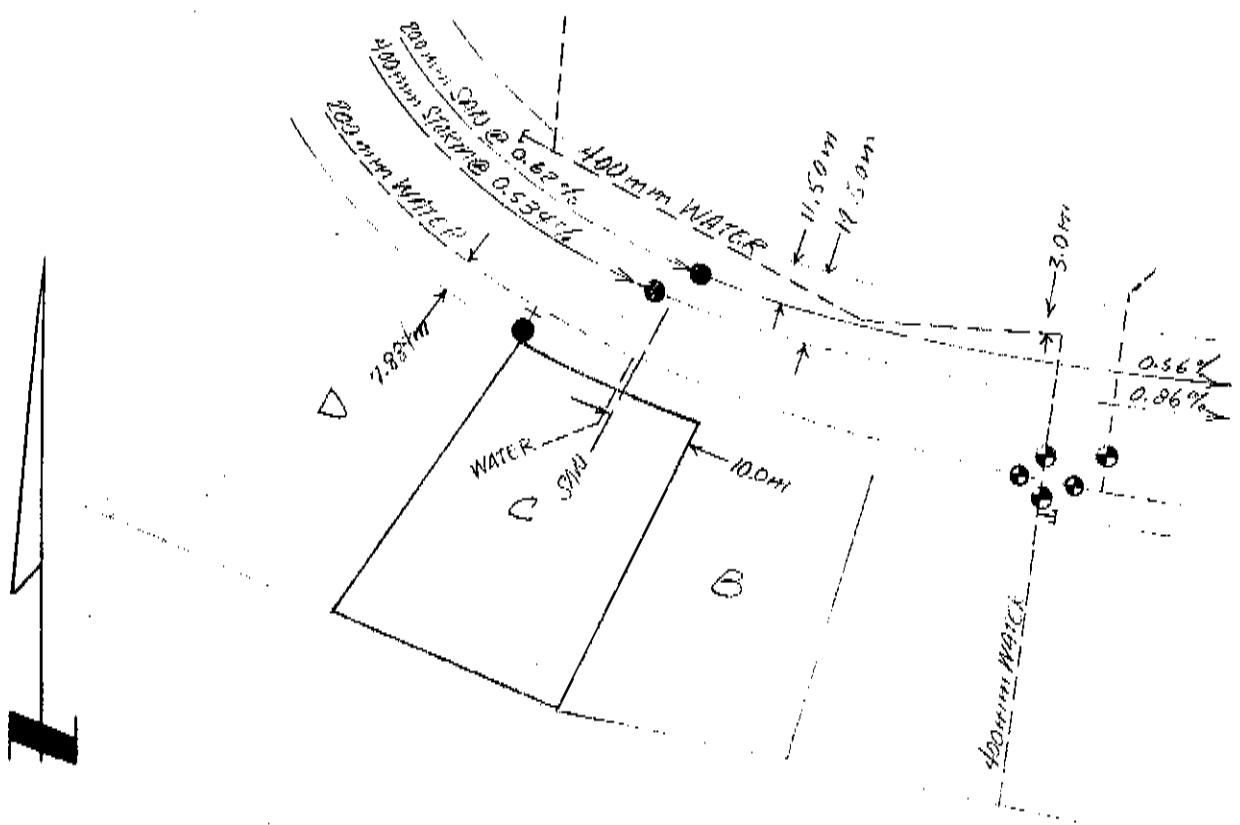

**City of Prince George
HISTORY SHEET**

D S

SHEET NUMBER **Nº 1635** Roll Number

Legal: LOT'S **D** BLOCK D.L. **4048** PLAN **S.D. 1153**

Address: **WEST AUSTIN RD.**

Sanitary Connection: # SIZE **100 mm** MATERIAL INV. **767.736m** CONNECTED

Water Connection # SIZE **20 mm** MATERIAL METER CONNECTED

Storm Connection: # SIZE MATERIAL INV. CONNECTED

Cash Receipt No's: WATER SANITARY STORM

CURB FROM PROPERTY LINE PAVEMENT WIDTH


B.C. HYDRO UNDERGROUND CONNECTION

B.C. TELEPHONE UNDERGROUND CONNECTION

INLAND GAS

Information Sheets:

Comments:

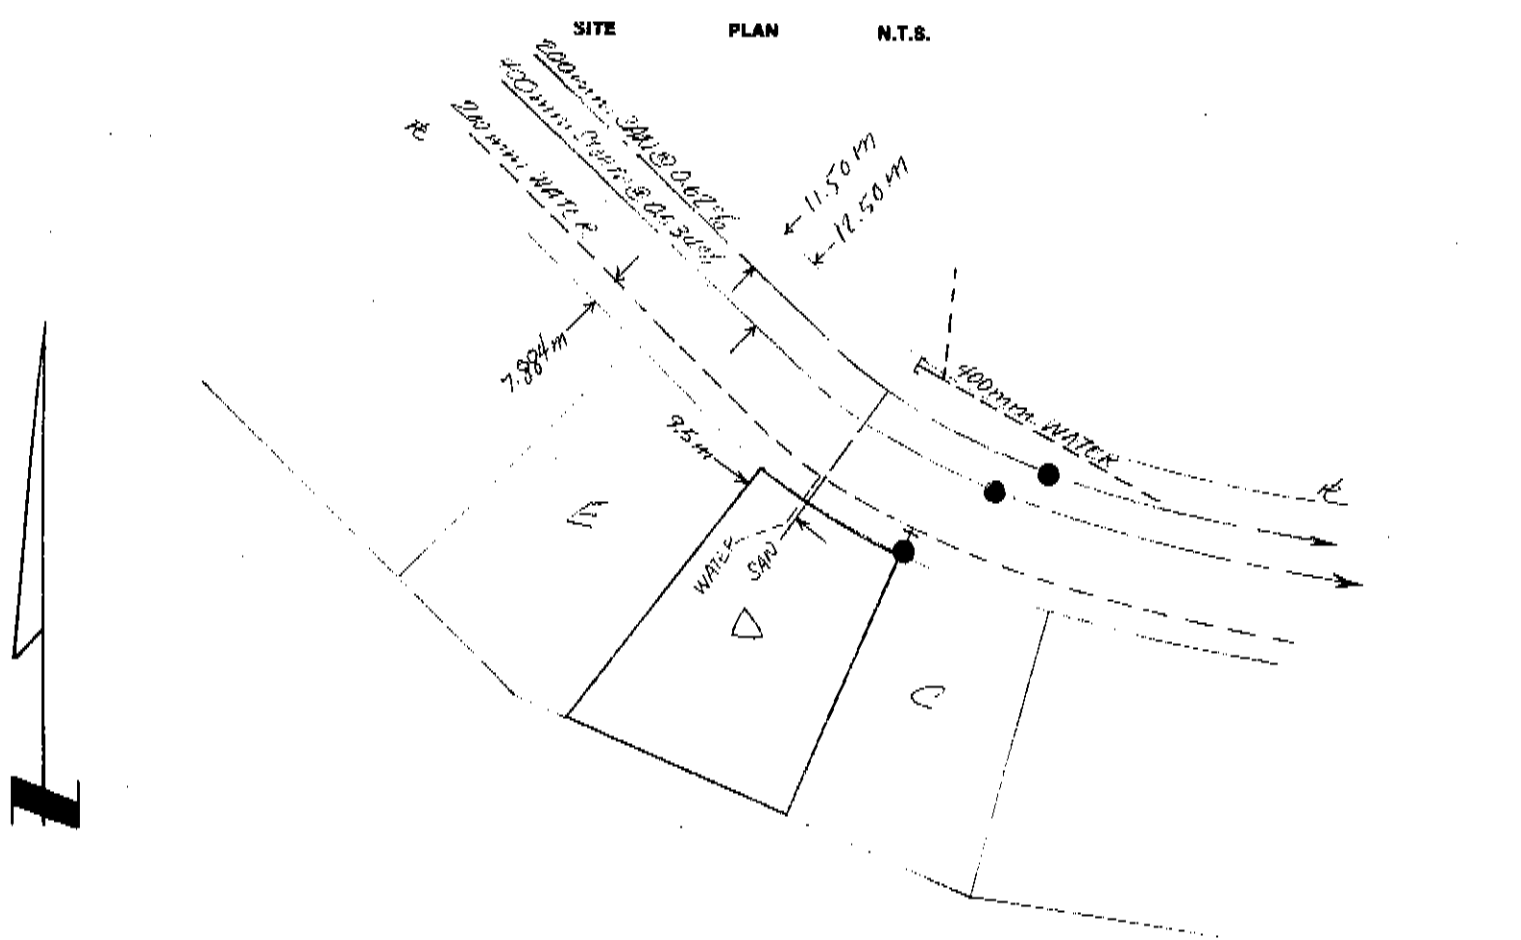

City of Prince George HISTORY SHEET

05

SHEET NUMBER **Nº 1636** Roll Number

Legal: LOT'S **E** BLOCK D.L. **4048** PLAN **S.D. 1153**

Address: **WEST AUSTIN RD.**

Sanitary Connection: # SIZE **100 mm** MATERIAL INV. **767.941 m** CONNECTED

Water Connection # SIZE **20 mm** MATERIAL METER CONNECTED

Storm Connection: # SIZE MATERIAL INV. CONNECTED

Cash Receipt No's: WATER SANITARY STORM

CURB FROM PROPERTY LINE PAVEMENT WIDTH


B.C. HYDRO UNDERGROUND CONNECTION

B.C. TELEPHONE UNDERGROUND CONNECTION

INLAND GAS

Information Sheets:

Comments:

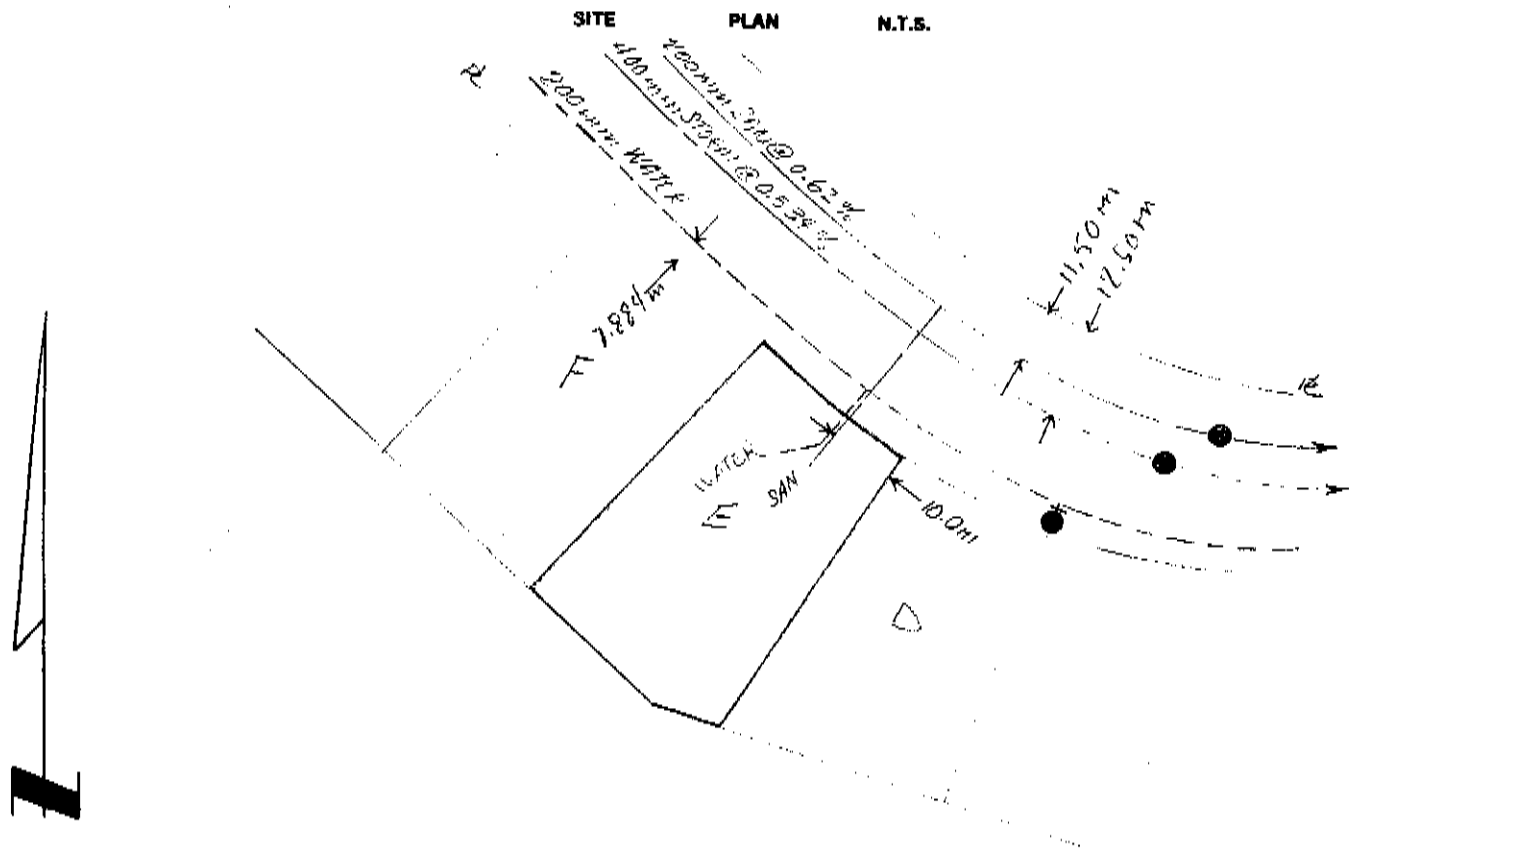

**City of Prince George
HISTORY SHEET**

DS

SHEET NUMBER **Nº 1637** Roll Number

Legal: LOT'S **F** BLOCK D.L. **4048** PLAN **S.D. 1153**

Address: **WEST AUSTIN RD.**

Sanitary Connection: # SIZE **100 MM** MATERIAL INV. **766.739m** CONNECTED

Water Connection # SIZE **20 MM** MATERIAL METER CONNECTED

Storm Connection: # SIZE MATERIAL INV. CONNECTED

Cash Receipt No's: WATER SANITARY STORM

CURB FROM PROPERTY LINE PAVEMENT WIDTH


B.C. HYDRO UNDERGROUND CONNECTION

B.C. TELEPHONE UNDERGROUND CONNECTION

INLAND GAS

Information Sheets:

Comments:

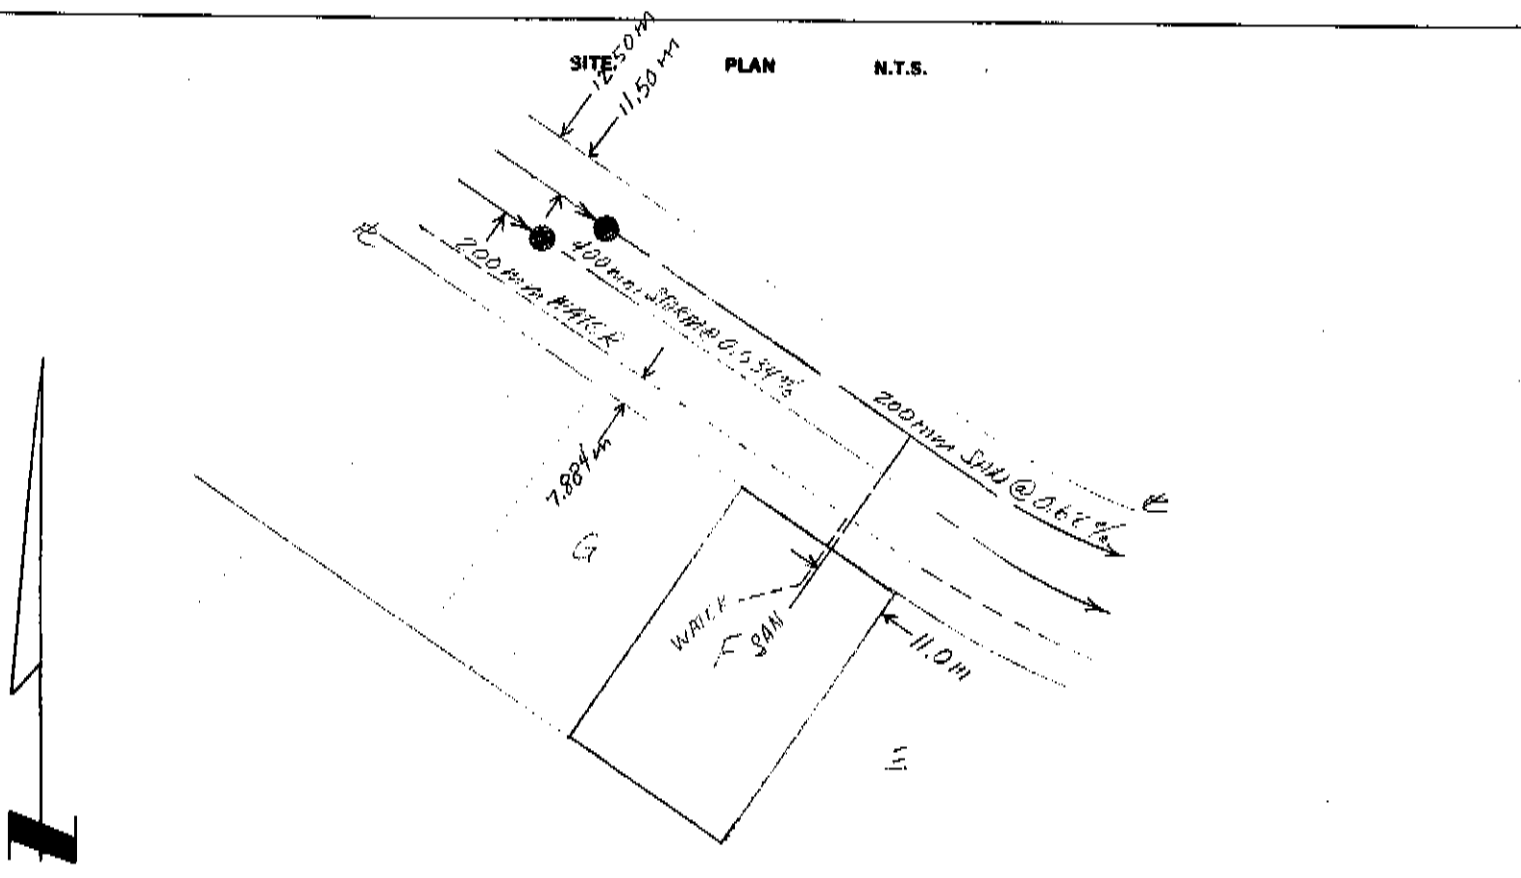

City of Prince George HISTORY SHEET

DS

SHEET NUMBER **Nº 1638** Roll Number

Legal: LOT'S **G** BLOCK **4048** D.L. **4048** PLAN **S.D. 1153**

Address: **WEST AUSTIN RD.**

Sanitary Connection: # SIZE **100 mm** MATERIAL INV. **767.603 m** CONNECTED

Water Connection # SIZE **20 mm** MATERIAL METER CONNECTED

Storm Connection: # SIZE MATERIAL INV. CONNECTED

Cash Receipt No's: WATER SANITARY STORM

CURB FROM PROPERTY LINE PAVEMENT WIDTH


B.C. HYDRO UNDERGROUND CONNECTION

B.C. TELEPHONE UNDERGROUND CONNECTION

INLAND GAS

Information Sheets:

Comments:

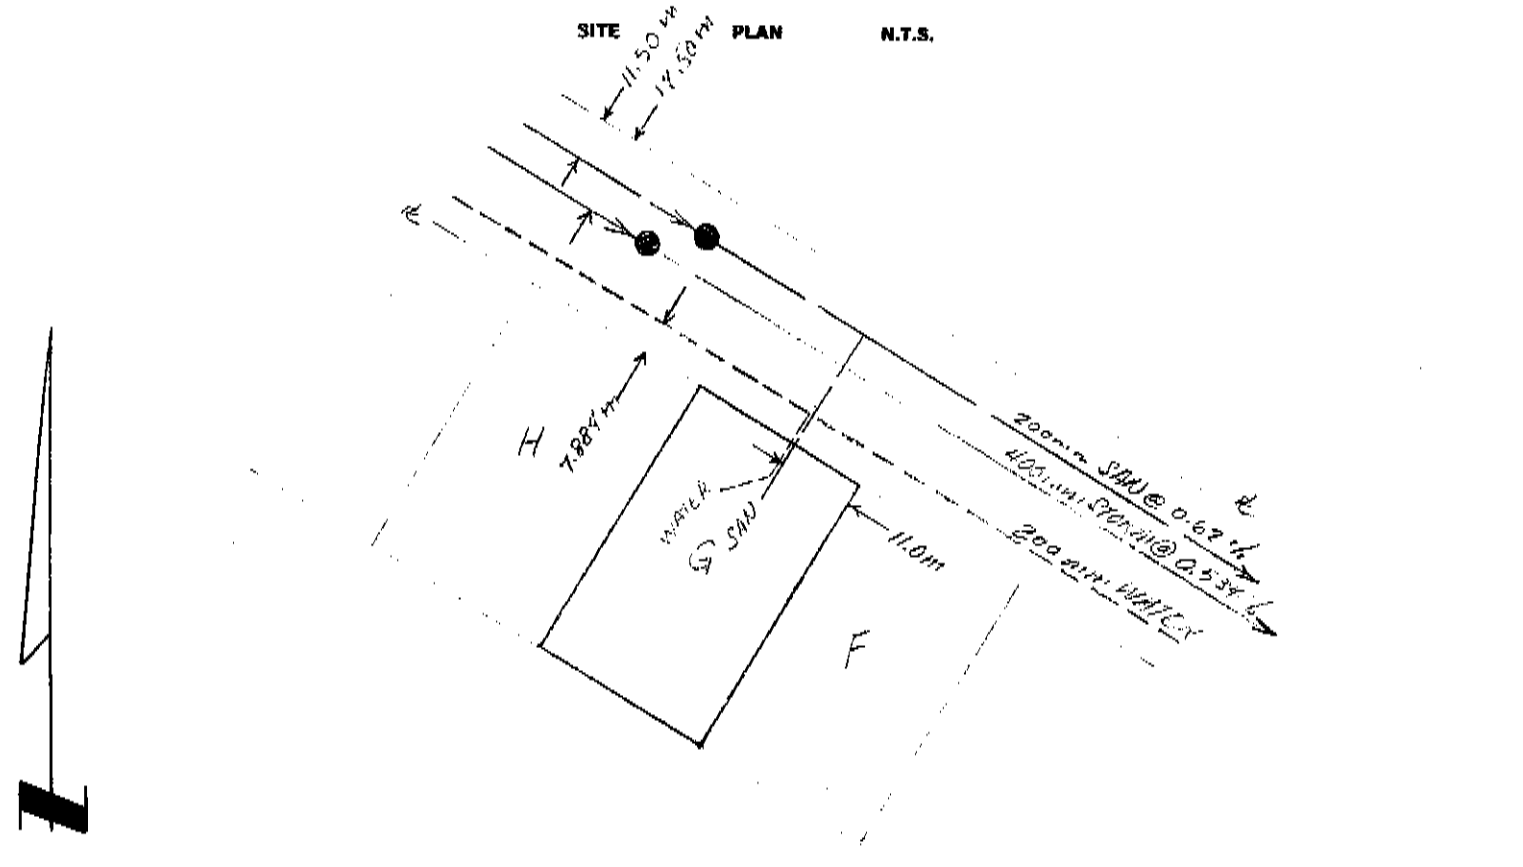

City of Prince George HISTORY SHEET

05

SHEET NUMBER **Nº 1639** Roll Number

Legal: LOT'S **H** BLOCK **4048** D.L. **4048** PLAN **S.D. 1153**

Address: **WEST AUSTIN RD.**

Sanitary Connection: # SIZE **100 mm** MATERIAL INV. **767.848 m** CONNECTED

Water Connection # SIZE **20 mm** MATERIAL METER CONNECTED

Storm Connection: # SIZE MATERIAL INV. CONNECTED

Cash Receipt No's: WATER SANITARY STORM

CURB FROM PROPERTY LINE PAVEMENT WIDTH


B.C. HYDRO UNDERGROUND CONNECTION

B.C. TELEPHONE UNDERGROUND CONNECTION

INLAND GAS

Information Sheets:

Comments:

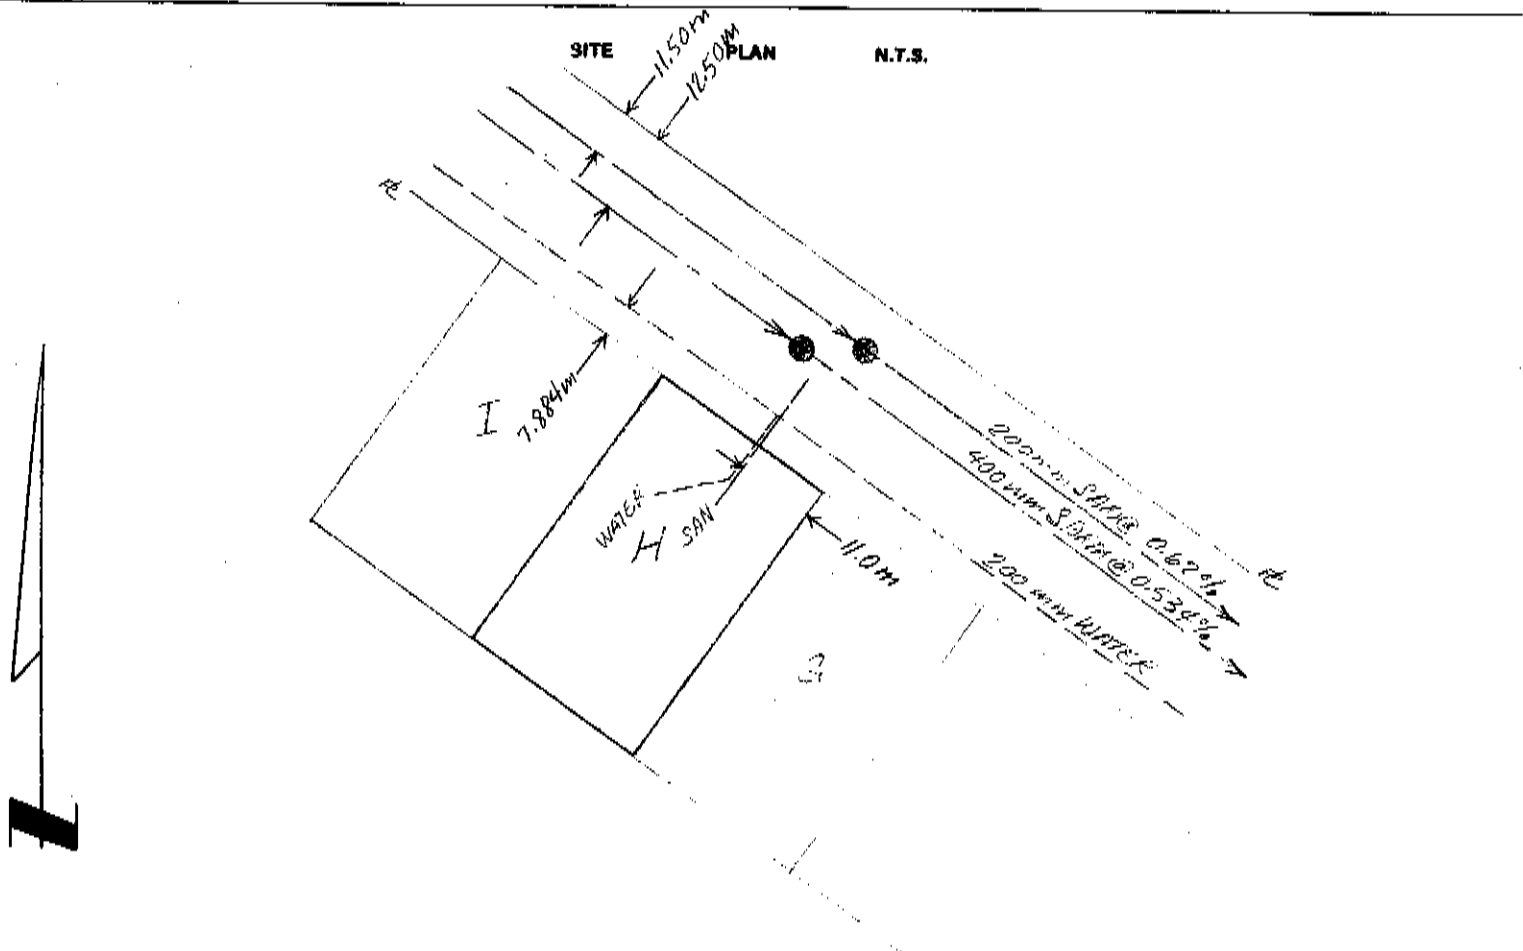

**City of Prince George
HISTORY SHEET**

D S

SHEET NUMBER **Nº 1640** Roll Number

Legal: LOT'S **I** BLOCK D.L. **4043** PLAN **S.D. 1153**

Address: **WEST AUSTIN RD.**

Sanitary Connection: # SIZE **100 mm** MATERIAL INV. **767.505 m** **CONNECTED**

Water Connection # SIZE **20 mm** MATERIAL METER **CONNECTED**

Storm Connection: # SIZE MATERIAL INV. **CONNECTED**

Cash Receipt No's: WATER SANITARY STORM

CURB FROM PROPERTY LINE PAVEMENT WIDTH

B.C. HYDRO UNDERGROUND CONNECTION

B.C. TELEPHONE UNDERGROUND CONNECTION

INLAND GAS

Information Sheets:

Comments:

