

**City of Prince George
HISTORY SHEET**

005718001
005718040 005717973
005718031 005717965

50

SHEET NUMBER

Roll Number 377-000

Legal: LOT'S 23-28 BLOCK 19 D.L. 343 PLAN 1268

Address: MANUFACTURERS LIFE 280-444 VICTORIA ST. (110 VICTORIA ST.)
IMPERIAL CROWN N A LIFE PRINCE GEORGE, B.C.

Sanitary Connection: # 5983 SIZE 4" MATERIAL PVC INV. 1873.05 CONNECTED YES.

Water Connection # 7 SIZE 1" MATERIAL Cu METER CONNECTED --

Storm Connection # - SIZE - MATERIAL - INV. - CONNECTED -

Cash Receipt No's: WATER - 0163 SANITARY 3251 STORM -

CURB FROM PROPERTY LINE 10' PAVEMENT WIDTH 60'

B.C. HYDRO O.H. UNDERGROUND CONNECTION --

B.C. TELEPHONE O.H. UNDERGROUND CONNECTION --




INLAND GAS ON 1ST AVE 6" Ø MAIN.

Information Sheets: 113

Comments: THE INFORMATION CONTAINED HEREIN IS FOR INTERNAL USE ONLY. NOT TO BE RELIED UPON UNLESS CONFIRMED BY SITE INSPECTION AND/OR INVESTIGATION.

SITE PLAN N.T.S.

1ST AVE

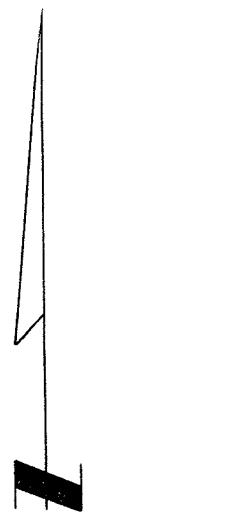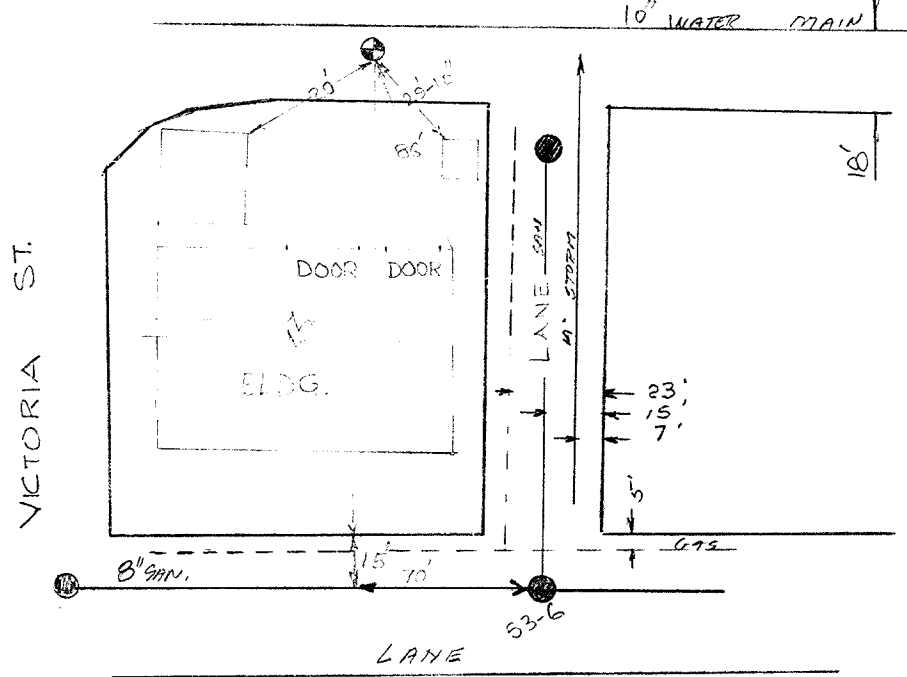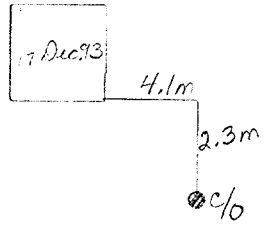

VICTORIA ST.

LANE

LANE 5M
4" STORM
53-6

8" GW.

10" WATER MAIN

23'
15'
7'

0.75