

**City of Prince George  
HISTORY SHEET**

005718001  
005718040  
005718031  
005717973  
005717965

**50**

SHEET NUMBER

Roll Number 377-000

Legal: LOT'S 23-28      BLOCK 19      D.L. 343      PLAN 1268

Address: MANUFACTURERS LIFE      280-444 VICTORIA ST.      (110 VICTORIA ST.)  
IMPERIAL CROWN N A LIFE      PRINCE GEORGE, B.C.

Sanitary Connection: # 5983      SIZE 4" <sup>150mm</sup>      MATERIAL PVC      INV. 1873.05      CONNECTED YES.

Water Connection # 7      SIZE 1"      MATERIAL Cu      METER      CONNECTED --

Storm Connection: # -      SIZE      MATERIAL      INV.      CONNECTED -

Cash Receipt No's: WATER - 0163      SANITARY 3251      STORM -

CURB FROM PROPERTY LINE 10'      PAVEMENT WIDTH 60'

B.C. HYDRO O.H.      UNDERGROUND CONNECTION --

B.C. TELEPHONE O.H.      UNDERGROUND CONNECTION --



INLAND GAS ON 1ST AVE 6" Ø MAIN.

Information Sheets: 113

Comments: **THE INFORMATION CONTAINED HEREIN IS FOR INTERNAL USE ONLY. NOT TO BE RELIED UPON UNLESS CONFIRMED BY SITE INSPECTION AND/OR INVESTIGATION.**

SITE PLAN N.T.S.

1ST AVE

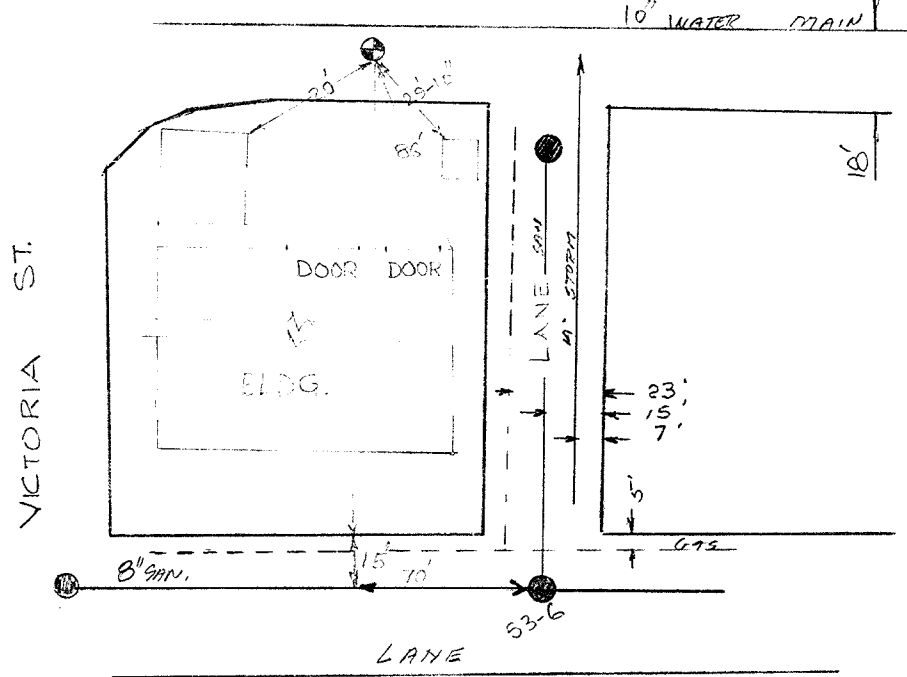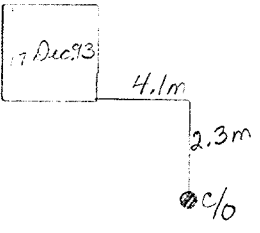

VICTORIA ST.

