



City of Prince George
History Sheet

PID:	005718627
	005718643
	005718660
SD/MU:	
WO:	5002967

Civic Address: 862 Gillett St

Legal Description: Lot: 26, 27, 28 Block: 22 District Lot: 1429 Plan: 646


Service Type	Diameter (mm)	Material	Invert Elev at main (m)	Invert Elev at property line (m)	Invert Depth at service end (m)	Distance into property (m)	Installation Date
Sanitary	100mm	AC	593.21	593.45	3.05	-	December 1959
Water	20mm	Copper	594.52	593.83	-	-	July 2016
Storm	N/A	N/A	-	-	-	-	

Service Connection Location				Sanitary (m)	Storm (m)
Distance from downstream San MH	1961	towards upstream San MH	1965	92.26	
Distance from downstream Stm MH	-	towards upstream Stm MH	-		

Power	Size	Communications	Size	Cable	Size	Gas	Size
BC Hydro	-	Telus	-	Shaw	-	FortisBC	-
Overhead Service		Overhead Service		Overhead Service			

Installed by:	City of Prince George forces	Survey Date:	-
Comments:			

NOT TO SCALE The information contained herein is for internal use only.
 Not to be relied on unless confirmed by site inspection and/or investigation.

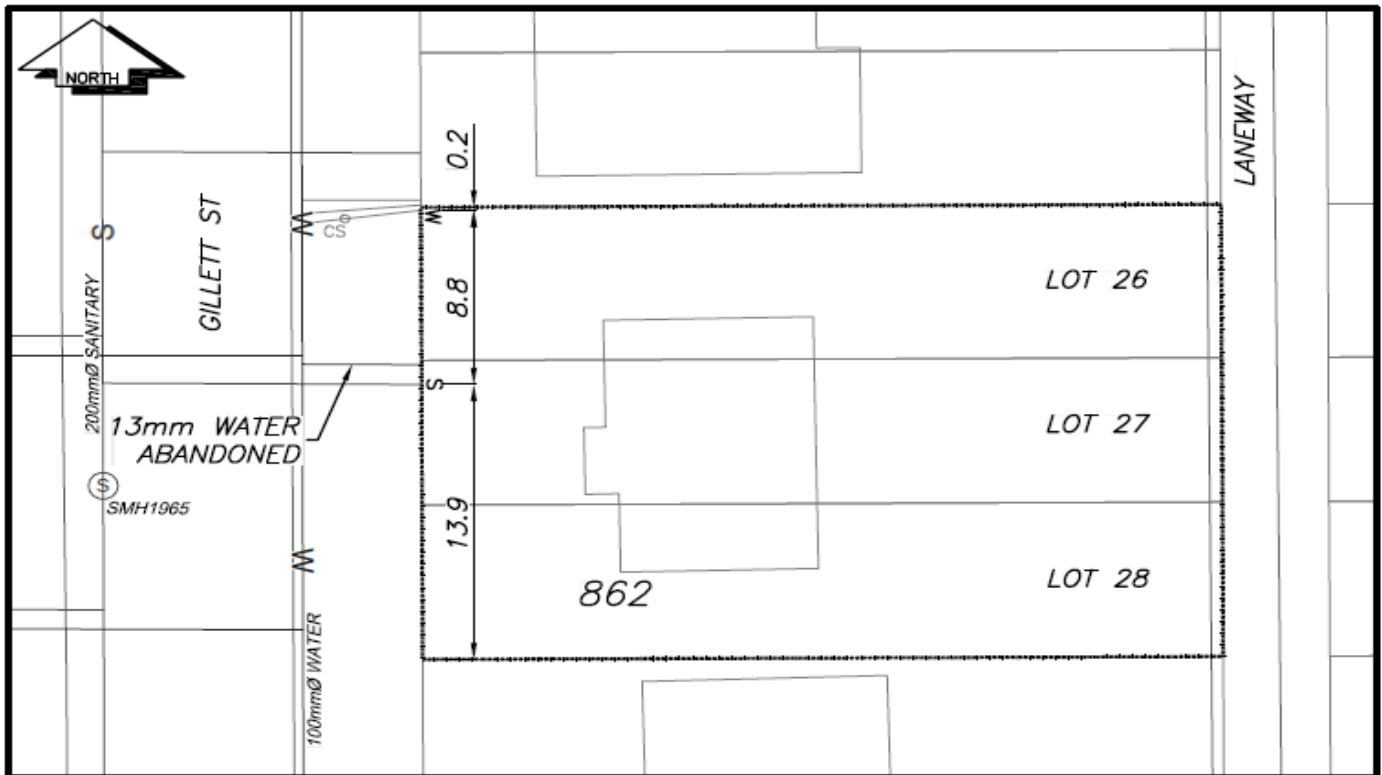

LEGEND:	
CS	CURB STOP
CO	CLEAN OUT
⊗	WATER VALVE
—W—	WATER SERVICE
- - - S - - -	SANITARY SERVICE
⊗	FIRE HYDRANT
- - - ○ - - -	STORM SERVICE
—G—	GAS
- - - - -	ENCUMBRANCE

NOT TO SCALE