



City of Prince George
History Sheet

PID:	005718996
	005719003
SD/MU:	
WO:	

Civic Address: 925 Freeman St

Legal Description: Lot: 9 ,10 Block: 23 District Lot: 1429 Plan: 646


Service Type	Diameter (mm)	Material	Invert Elev at main (m)	Invert Elev at property line (m)	Invert Depth at service end (m)	Distance into property (m)	Installation Date
Sanitary	100mm	AC	591.05	592.11	1.37	1.20	January 1960
Water	13mm	Unknown	-	-	-	-	January 1954
Storm	N/A	N/A	-	-	-	-	

Service Connection Location				Sanitary (m)	Storm (m)
Distance from downstream San MH	1973	towards upstream San MH	3061	46.96	
Distance from downstream Stm MH	-	towards upstream Stm MH	-		

Power	Size	Communications	Size	Cable	Size	Gas	Size
BC Hydro	-	Telus	-	Shaw	-	FortisBC	-
Overhead Service		Overhead Service		Overhead Service			

Installed by:		Survey Date:	-
Comments:	Water and Sanitary services as per April 2017 locates.		

NOT TO SCALE The information contained herein is for internal use only.
Not to be relied on unless confirmed by site inspection and/or investigation.

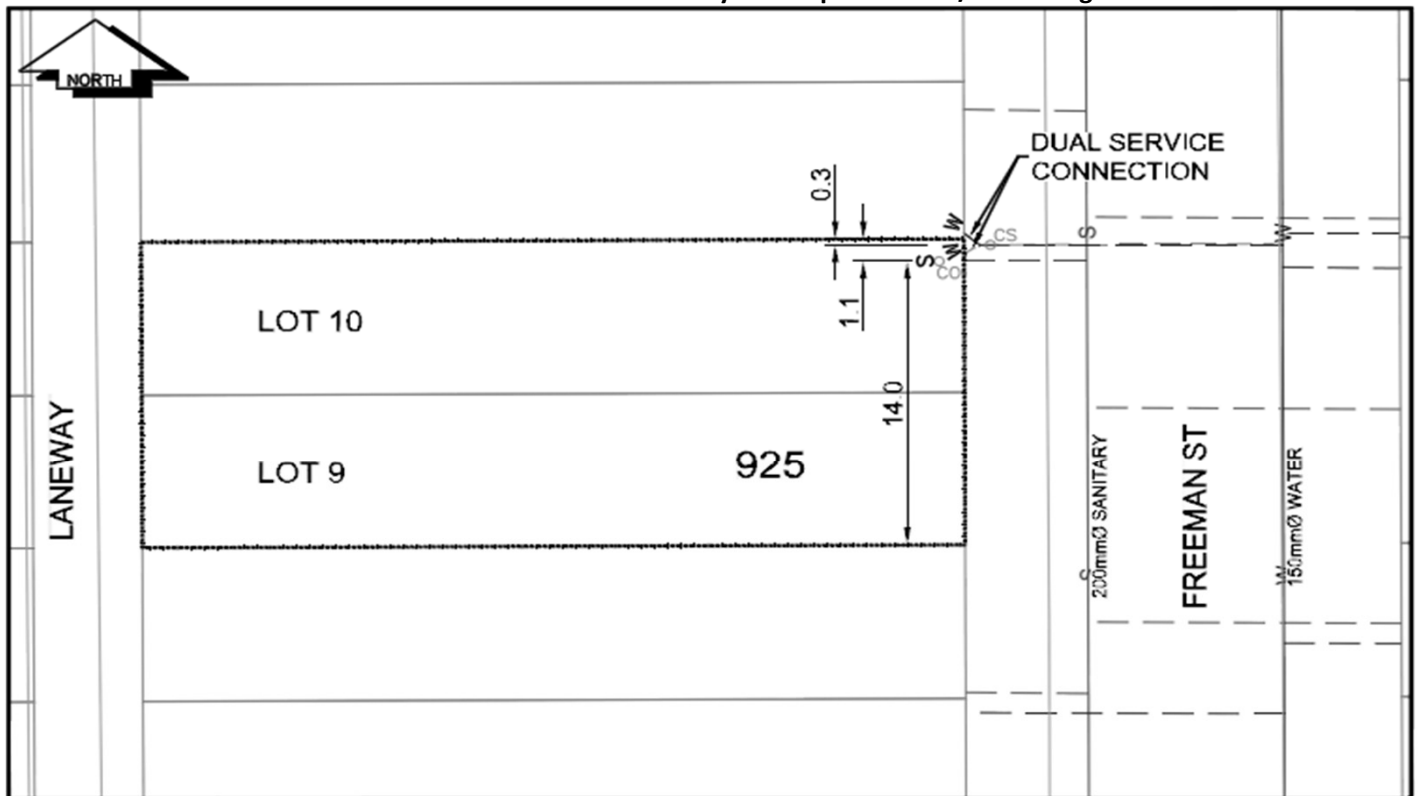

LEGEND:	CS ^o CURB STOP	--- W WATER SERVICE	--- S STORM SERVICE
	CO ^o CLEAN OUT	--- S SANITARY SERVICE	--- G GAS
	⊗ WATER VALVE	⊗ FIRE HYDRANT	--- ENCUMBRANCE

NOT TO SCALE