



City of Prince George
History Sheet

PID:	005719844
SD/MU:	
WO:	5018867

Civic Address: 2305 Laurier Cres

Legal Description: Lot: A District Lot: 343 Plan: 29315


Service Type	Diameter (mm)	Material	Invert Elev at main (m)	Invert Elev at property line (m)	Invert Elev at service end (m)	Distance into property (m)	Installation Date
Sanitary	100mm	AC	-	585.90	-	-	January 1957
Water	20mm	Copper	585.82	585.72	-	-	June 2020
Storm	N/A	N/A	-	-	-	-	

Service Connection Location				Sanitary (m)	Storm (m)
Distance from downstream San MH	1983	towards upstream San MH	1979	31.74	
Distance from downstream Stm MH	-	towards upstream Stm MH	-		

Power	Size	Communications	Size	Cable	Size	Gas	Size
BC Hydro	-	Telus	-	Shaw	-	FortisBC	-
Overhead Service		Overhead Service		Overhead Service			

Installed by:	Survey Date:	-
Comments:		

NOT TO SCALE The information contained herein is for internal use only.
 Not to be relied on unless confirmed by site inspection and/or investigation.

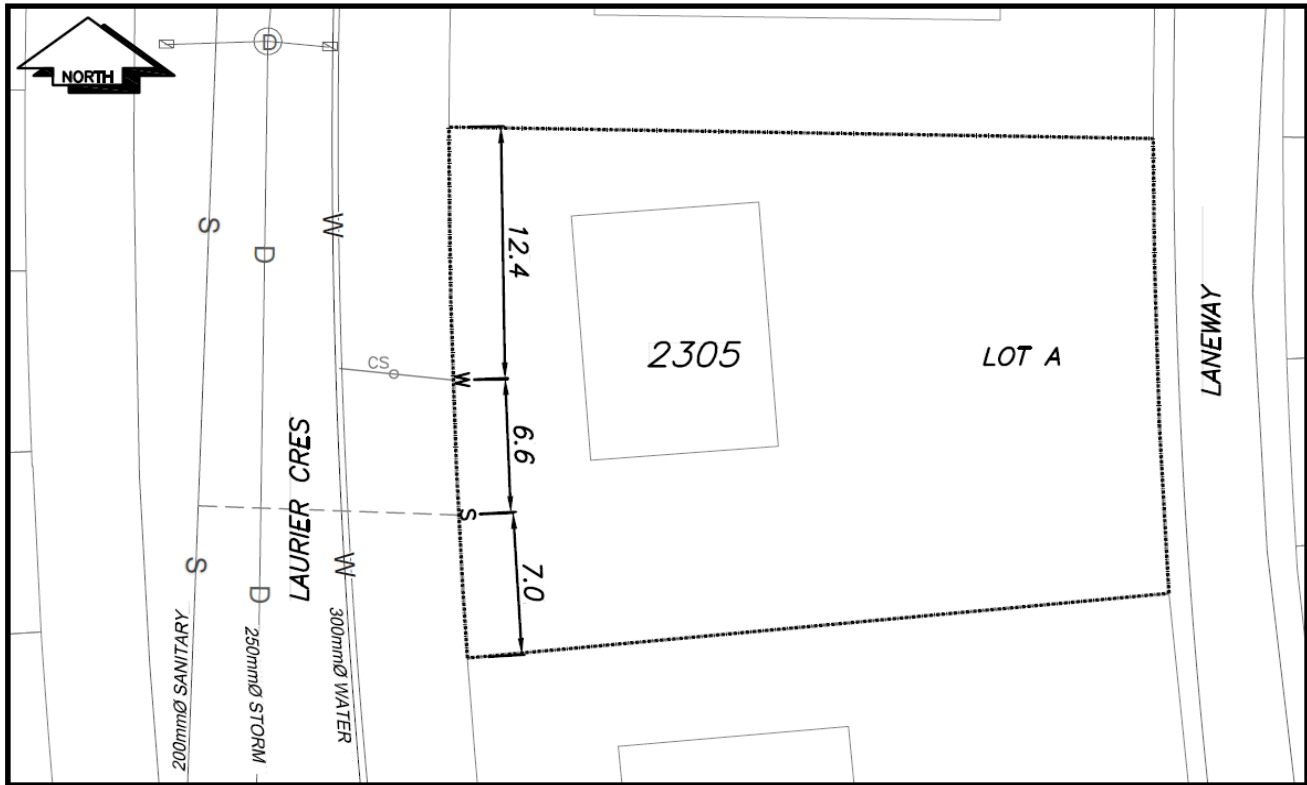

LEGEND:					
CS	CURB STOP	W	WATER SERVICE	⊕	STORM SERVICE
CO	CLEAN OUT	- - -	SANITARY SERVICE	- G -	GAS
⊗	WATER VALVE	⊗ ⊕	FIRE HYDRANT	- - - -	ENCUMBRANCE

NOT TO SCALE