



City of Prince George

PID:	005720192
	005720206
	005720214
SD/MU:	
WO:	

History Sheet

Civic Address: 175, 181 Quebec Street
 Legal Description: Lot: 5 District Lot: 343 Plan: 1268
 Lot: 6 District Lot: 343 Plan: 1268
 Lot: 7 District Lot: 343 Plan: 1268


Service Type	Diameter (mm)	Material	Invert Elev at main (m)	Invert Elev at property line (m)	Invert Elev at service end (m)	Distance into property (m)	Installation Date
Sanitary	Unknown	Unknown	-	-	-	-	January 1959
Water	13mm	Copper	-	-	-	-	January 1968
Water	13mm	Copper	-	-	-	-	January 1968
Storm	150mm	Vit	-	-	-	-	January 1974

Service Connection Location				Sanitary (m)	Storm (m)
Distance from downstream San MH	1871	towards upstream San MH	2710	-	
Distance from downstream Stm MH	3066	towards upstream Stm MH	3438		59.40

Power	Size	Communications	Size	Cable	Size	Gas	Size
BC Hydro	-	Telus	-	Shaw	-	FortisBC	-
Overhead Service		Overhead Service		Overhead Service			

Installed by:	Survey Date:	-
Comments:		

NOT TO SCALE The information contained herein is for internal use only.
 Not to be relied on unless confirmed by site inspection and/or investigation.

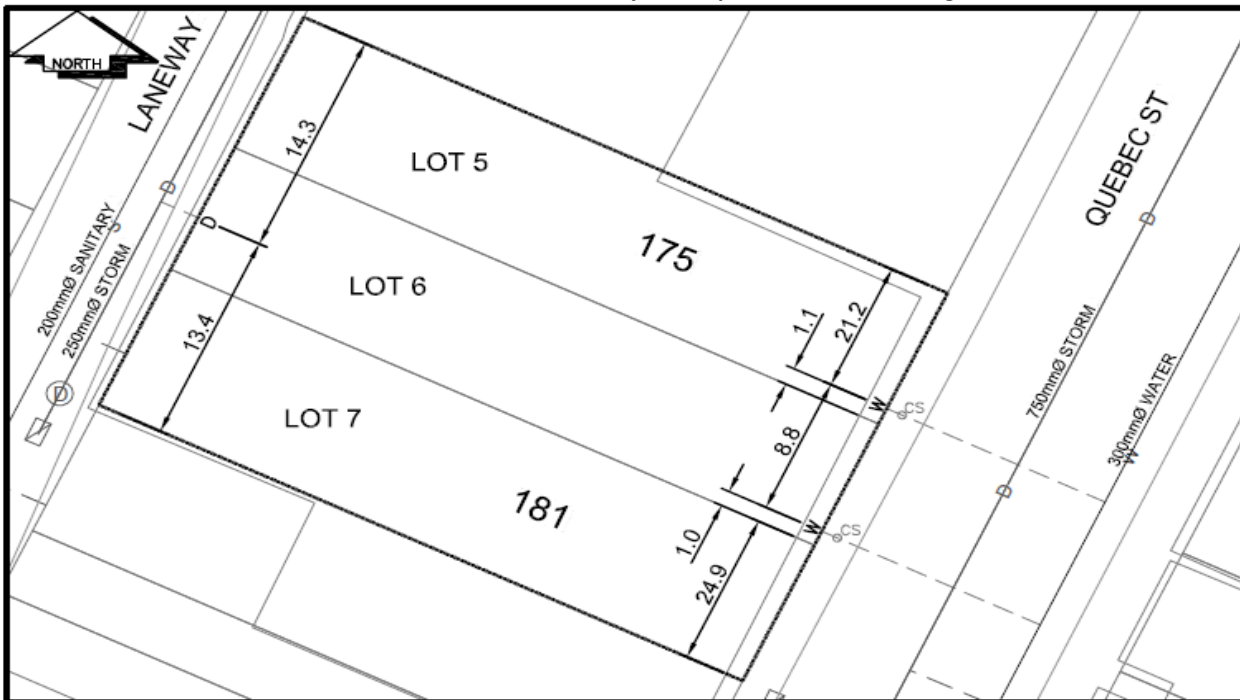

LEGEND:	
CS	CURB STOP
CO	CLEAN OUT
⊗	WATER VALVE
---	WATER SERVICE
---	SANITARY SERVICE
⊗	FIRE HYDRANT
---	STORM SERVICE
G	GAS
---	ENCUMBRANCE

NOT TO SCALE