

**City of Prince George  
HISTORY SHEET**

005721318

SHEET NUMBER

Roll Number

**Legal:** LOT'S 7 BLOCK \_\_\_\_\_ D.L. 4097 PLAN 16650

**Address:** 6233 CROWN DRIVE

**Sanitary Connection:** # 15519 SIZE 100mm MATERIAL \_\_\_\_\_ INV. \_\_\_\_\_ CONNECTED \_\_\_\_\_

**Water Connection** # \_\_\_\_\_ SIZE 20mm MATERIAL COPPER METER \_\_\_\_\_ CONNECTED \_\_\_\_\_

**Storm Connection:** # \_\_\_\_\_ SIZE \_\_\_\_\_ MATERIAL \_\_\_\_\_ INV. \_\_\_\_\_ CONNECTED \_\_\_\_\_

**Cash Receipt No's:** WATER \_\_\_\_\_ SANITARY \_\_\_\_\_ STORM \_\_\_\_\_

CURB FROM PROPERTY LINE \_\_\_\_\_ PAVEMENT WIDTH \_\_\_\_\_

B.C. HYDRO \_\_\_\_\_ UNDERGROUND CONNECTION \_\_\_\_\_



B.C. TELEPHONE \_\_\_\_\_ UNDERGROUND CONNECTION \_\_\_\_\_

INLAND GAS \_\_\_\_\_

**Information Sheets:**

**Comments:**

SITE PLAN N.T.S.

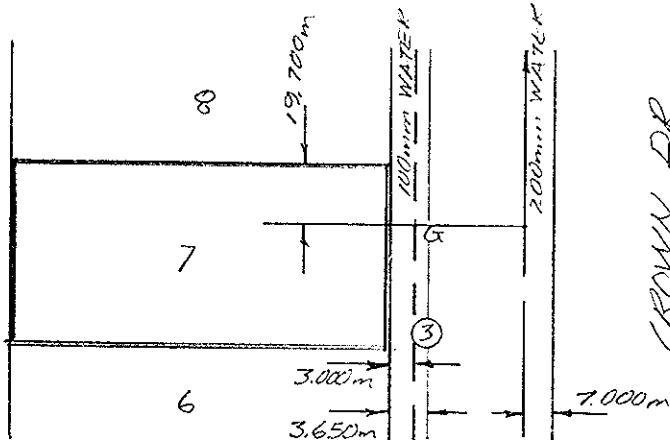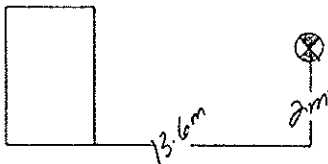

CROWN DR.

