

City of Prince George
HISTORY SHEET

005726255

SHEET NUMBER

Roll Number

Legal: LOT'S *B* BLOCK D.L. *2166* PLAN *29183*

Address: *956 P.G. PULPMILL RD.*

Sanitary Connection: # SIZE MATERIAL INV. CONNECTED

Water Connection # SIZE MATERIAL METER CONNECTED

Storm Connection: # SIZE MATERIAL INV. CONNECTED

Cash Receipt No's: WATER SANITARY STORM

CURB FROM PROPERTY LINE PAVEMENT WIDTH

B.C. HYDRO UNDERGROUND CONNECTION


B.C. TELEPHONE UNDERGROUND CONNECTION

INLAND GAS

Information Sheets:

Comments:

SITE PLAN N.T.S.

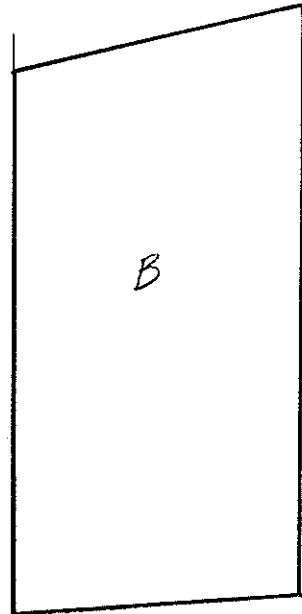

PRINCE GEORGE PULPMILL ROAD