



City of Prince George
History Sheet

PID:	005729033
MU:	102281
WO:	103639

Civic Address: 1396 Douglas St

Legal Description: Lot: A Block: 2 District Lot: 1429 Plan: 646


Service Type	Diameter (mm)	Material	Invert Elev at main (m)	Invert Elev at property line (m)	Invert Elev at service end (m)	Distance into property (m)	Installation Date
Sanitary	100mm	PVC	587.94	588.29	588.65	2.80	August 2020
Water	20mm	Copper	588.44	588.52	588.55	2.80	August 2020
Storm	N/A	N/A	-	-	-	-	

Service Connection Location				Sanitary (m)	Storm (m)
Distance from downstream San MH	731	towards upstream San MH	735	100.23	
Distance from downstream Stm MH	-	towards upstream Stm MH	-		

Power	Size	Communications	Size	Cable	Size	Gas	Size
BC Hydro	-	Telus	-	Shaw	-	FortisBC	-
Overhead Service		Overhead Service		Overhead Service			

Installed by:	City of Prince George forces	Survey Date:	-
Comments:			

NOT TO SCALE The information contained herein is for internal use only.
Not to be relied on unless confirmed by site inspection and/or investigation.

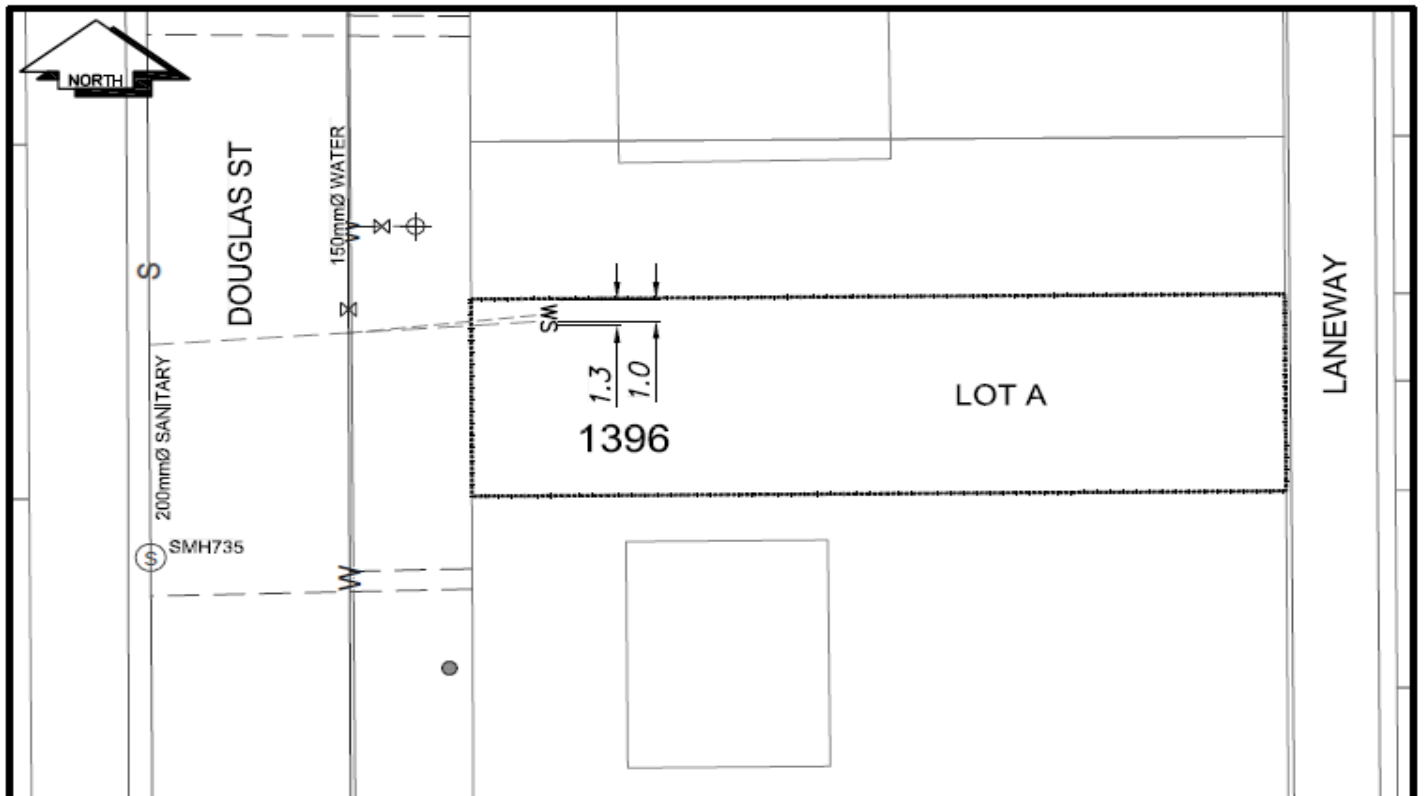

LEGEND:	CS ^o CURB STOP	— W — WATER SERVICE	— O — STORM SERVICE
	CO ^o CLEAN OUT	- - - S - - - SANITARY SERVICE	— G — GAS
	X WATER VALVE	X FH FIRE HYDRANT	- - - ENCUMBRANCE

NOT TO SCALE