



City of Prince George

PID:	005720460
	005720427
	005730554
SD/MU:	
WO:	

## History Sheet

Civic Address: 185, 191 Quebec Street  
 Legal Description: Lot: 8 Block: 20 District Lot: 343 Plan: 1268  
 Lot: 9 Block: 20 District Lot: 343 Plan: 1268  
 Lot: PCL A of Lot 9 Block: 20 District Lot: 343 Plan: 1268


Service Type	Diameter (mm)	Material	Invert Elev at main (m)	Invert Elev at property line (m)	Invert Elev at service end (m)	Distance into property (m)	Installation Date
Sanitary (SE)	100mm	AC	-	-	-	-	January 1959
Sanitary (NW)	100mm	AC	-	-	-	-	January 1959
Water	40mm	Copper	-	-	-	-	January 1968
Storm	200mm	Unknown	-	-	-	-	January 1974

Service Connection Location				Sanitary (m)	Storm (m)
Distance from downstream San MH	1874	towards upstream San MH	1871	30.03	
Distance from downstream San MH	1871	towards upstream San MH	2710	15.41	
200mm Storm service connected to Stm MH3438					

Power	Size	Communications	Size	Cable	Size	Gas	Size
BC Hydro	-	Telus	-	Shaw	-	FortisBC	-
Overhead Service		Overhead Service		Overhead Service			

Installed by:	Survey Date:	-
Comments: Water service location confirmed May 2013		

**NOT TO SCALE** The information contained herein is for internal use only.  
 Not to be relied on unless confirmed by site inspection and/or investigation.

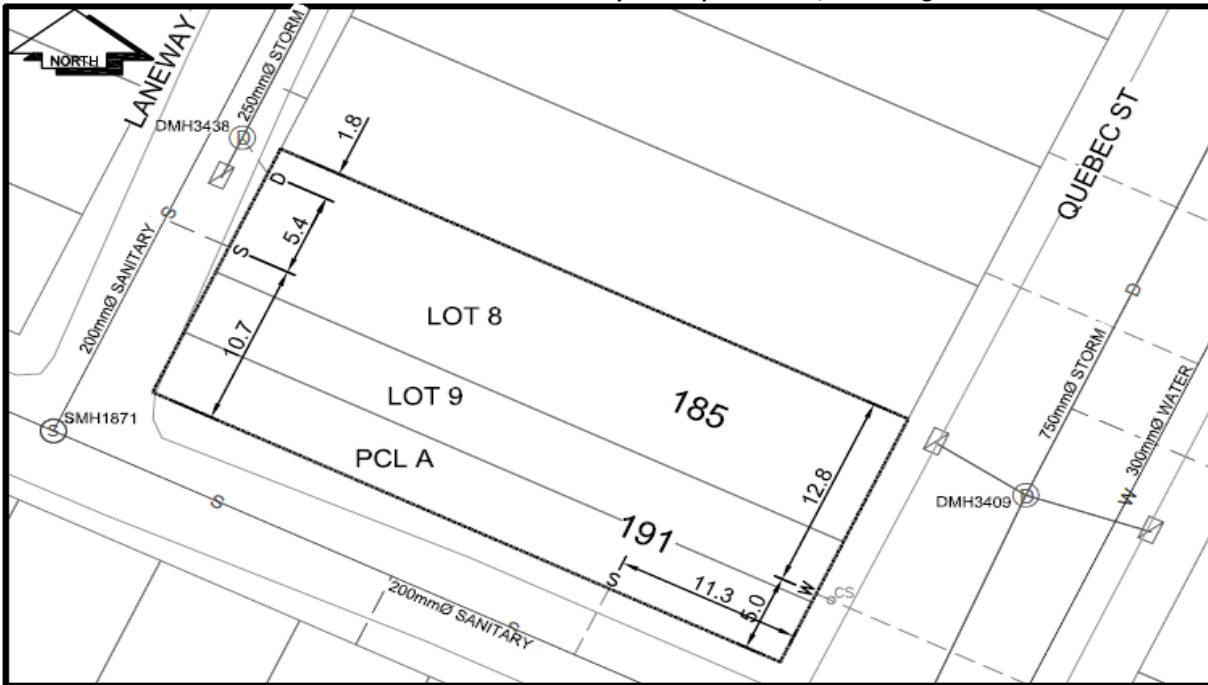

LEGEND:	
	CURB STOP
	CLEAN OUT
	WATER VALVE
	WATER SERVICE
	SANITARY SERVICE
	FIRE HYDRANT
	STORM SERVICE
	GAS
	ENCUMBRANCE

NOT TO SCALE