



City of Prince George  
**History Sheet**

PID:	005730562
PID:	005730571
WO:	

Civic Address: 1340 2nd Avenue  
1350 2nd Ave

Legal Description: Lot: 13 Block: 20 District Lot: 343 Plan: 1268

Legal Description: Lot: 14 Block: 20 District Lot: 343 Plan: 1268


Service Type	Diameter (mm)	Material	Invert Elev at main (m)	Invert Elev at property line (m)	Invert Depth at service end (m)	Distance into property (m)	Installation Date
Sanitary (Lot 13)	100mm	AC	-	-	-	-	January 1957
Sanitary (Lot 14)	100mm	AC	-	-	-	-	January 1957
Water (Lot 13)	20mm	Copper	-	-	-	-	January 1968
Water (Lot 14)	20mm	Copper	-	-	-	-	January 1968
Storm (Lot 13)	100mm	Vit	-	-	-	-	January 1959
Storm (Lot 14)	100mm	Vit	-	570.32	1.63	-	August 1964

Service Connection Location				Sanitary (m)	Storm (m)
Distance from downstream San MH	1877	towards upstream San MH	1872	48.67	
Distance from downstream San MH	1877	towards upstream San MH	1872	56.02	
Distance from downstream Stm MH	2201	towards upstream Stm MH	2200		37.10
Distance from downstream Stm MH	2201	towards upstream Stm MH	2200		46.06

Power	Size	Communications	Size	Cable	Size	Gas	Size
BC Hydro	-	Telus	-	Shaw	-	FortisBC	-
Overhead Service		Overhead Service		Overhead Service			

Installed by:		Survey Date:	-
Comments:	Services materials as per discussion with Louis N.		

**NOT TO SCALE** The information contained herein is for internal use only.  
Not to be relied on unless confirmed by site inspection and/or investigation.

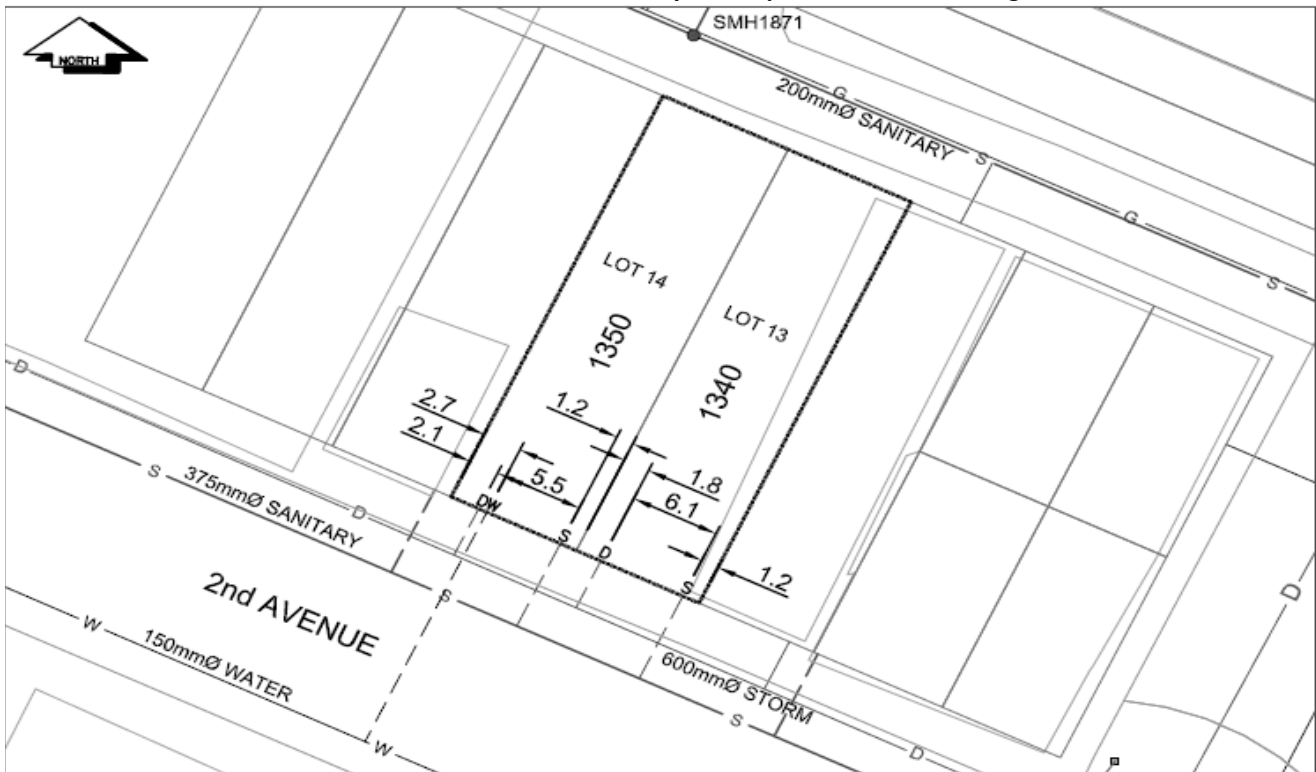

LEGEND:

CS <sup>o</sup>	CURB STOP	---	W	WATER SERVICE	---	D	STORM SERVICE
CO <sup>o</sup>	CLEAN OUT	---	S	SANITARY SERVICE	---	G	GAS

**NOT TO SCALE**

**NOT TO SCALE**