

City of Prince George HISTORY SHEET

SHEET NUMBER

PID # 005 731 437

Legal: LOTS 78 BLOCK D.L. 777 PLAN 17 401

Address: 2615 BORDEN CRES.

Sanitary Connection: # 6475 SIZE 100 mm MATERIAL A.C. INV. 586.025 CONNECTED

Water Connection: # 6475 SIZE 20 mm MATERIAL CU. METER CONNECTED

Storm Connection: # SIZE mm MATERIAL INV. CONNECTED

Cash Receipt No's: WATER SANITARY STORM

CURB FROM PROPERTY LINE 4,877 m PAVEMENT WIDTH 10.363 m

B.C. HYDRO U/G UNDERGROUND CONNECTION



B.C. TELEPHONE U/G UNDERGROUND CONNECTION

INLAND GAS 3,048 m FROM R.

Information Sheets:

Comments:

**THE INFORMATION CONTAINED HEREIN IS FOR INTERNAL USE ONLY.
NOT TO BE RELIED UPON UNLESS CONFIRMED BY SITE INSPECTION AND/OR INVESTIGATION**

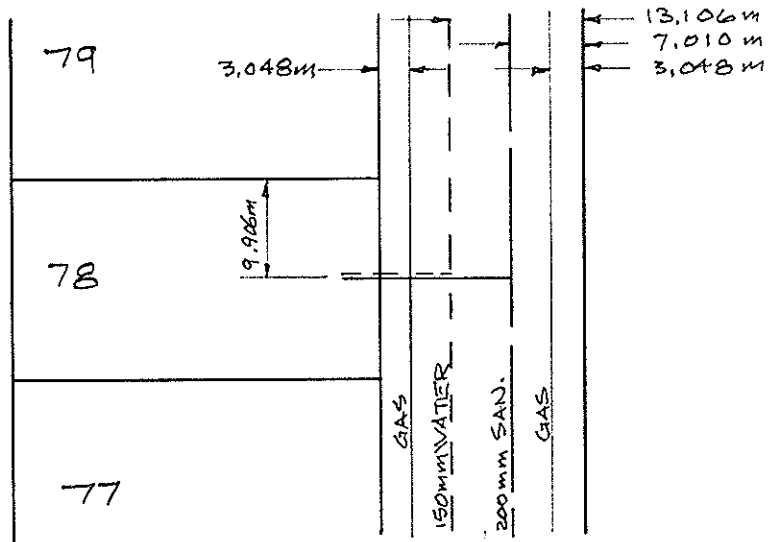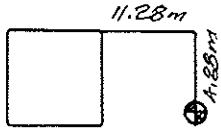

BORDEN CRES.

