



City of Prince George
History Sheet

PID:	005759234
	005759251
SD/MU:	
WO:	

Civic Address: 1944, 1946 Hemlock St

Legal Description: Lot: 15, 16 Block: 346 District Lot: 343 Plan: 1268


Service Type	Diameter (mm)	Material	Invert Elev at main (m)	Invert Elev at property line (m)	Invert Elev at service end (m)	Distance into property (m)	Installation Date
Sanitary	100mm	AC	-	-	-	-	December 1955
Water	20mm	Copper	-	-	-	-	December 1955
Storm	N/A	N/A	-	-	-	-	

Service Connection Location				Sanitary (m)	Storm (m)
Distance from downstream San MH	3310	towards upstream San MH	3305	49.03	
Distance from downstream Stm MH	-	towards upstream Stm MH	-		

Power	Size	Communications	Size	Cable	Size	Gas	Size
BC Hydro	-	Telus	-	Shaw	-	FortisBC	-
Overhead Service		Overhead Service		Overhead Service			

Installed by:		Survey Date:	-
Comments:	Sanitary service confirmed May 11, 1989		

NOT TO SCALE The information contained herein is for internal use only.
Not to be relied on unless confirmed by site inspection and/or investigation.

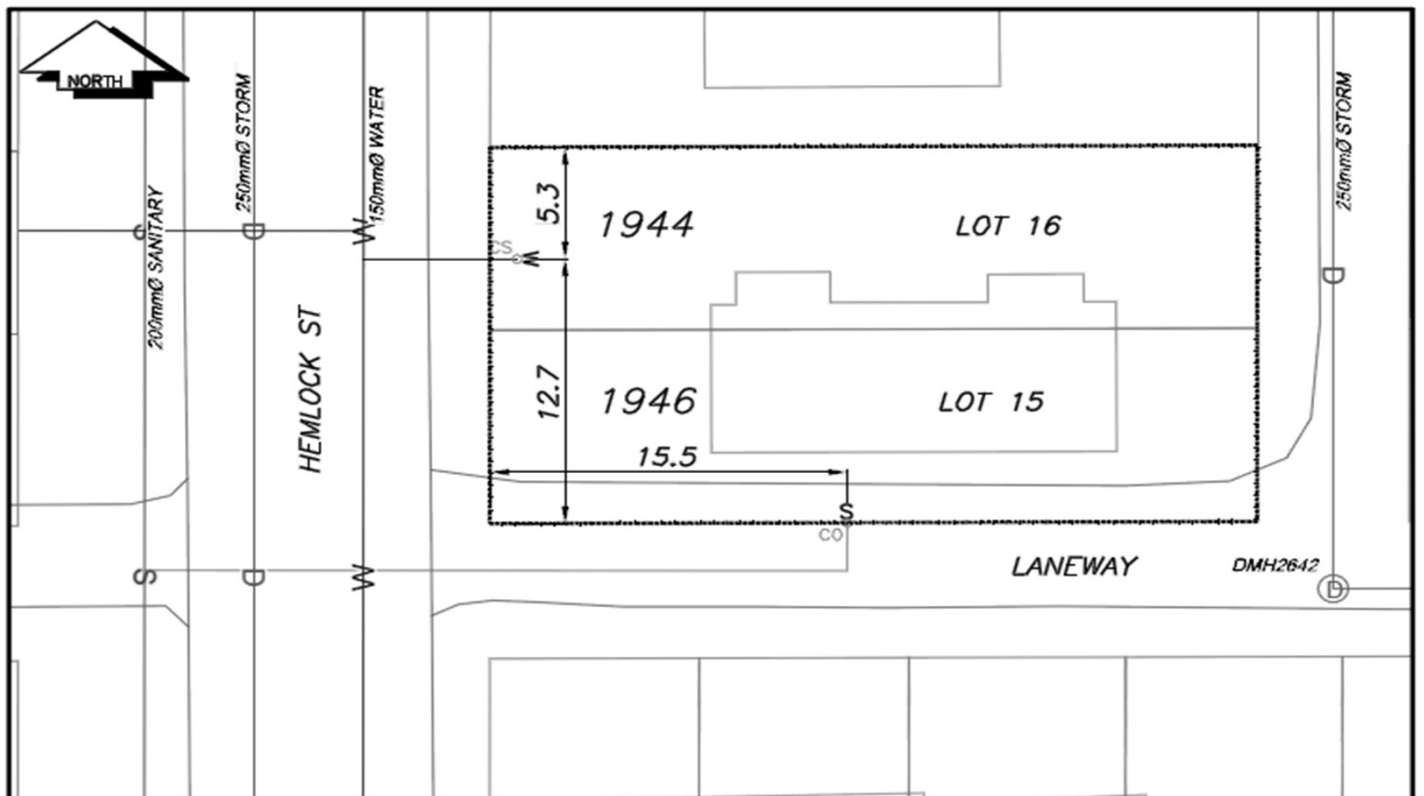

CURB STOP	WATER SERVICE	STORM SERVICE
CLEAN OUT	SANITARY SERVICE	GAS
WATER VALVE	FIRE HYDRANT	ENCUMBRANCE

NOT TO SCALE